

CERTIFIED RECORD OF LAND CORNER MONUMENTATION


History of original corner establishment:

Corner established by W. B. Barr under GLO contract no. 503 dated May 23, 1884.

Surveyor General's records state:

Set granite rock, 20 x 16 x 8 ins. 15 ins. in ground for 1/4 sec. cor. marked 1/4 on W side, from which

A fir, 5 ins. diam, bears N 52° E, 52 lks dist, marked 1/4 S BT  
A fir, 7 ins. diam, bears N 45° E, 25 lks dist, marked 1/4 S BT

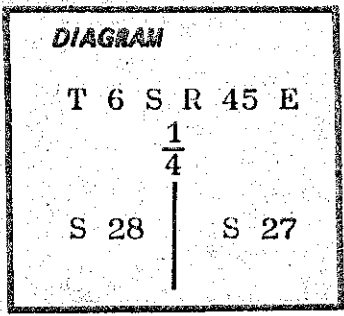


Description of corner evidence found:

Found a 1 inch diam pipe which was accepted for the 1/4 sec. cor.

Description of monument and accessories established to perpetuate the original location of this corner:

Set a 2 1/2 inch brass cap on a 2 inch iron pipe, 31 inches long, and projecting 6 inches out of the ground with a surrounding rock mound.

Brass cap marked thus: T 6 S R 45 E

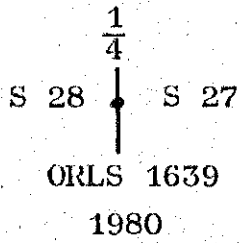

New bearing trees:

A fir 19 ins diam bears N 30° E, 37.8 feet marked 1/4 S 27 BT  
A fir 25 ins diam bears S 28° W, 15.6 feet marked 1/4 S 28 BT

Each new bearing tree has a brass washer marked PLS 1639 nailed flush with BT blaze and has a 6 inch band of red paint above upper blaze.

I hereby certify that this corner was properly re-established under my direct supervision on Oct. 14, 1980, and witnessed by Brad Gordon and Tom Fisk.

REGISTERED  
PROFESSIONAL  
LAND SURVEYOR

*William L. Hanley*

OREGON  
JULY 14, 1978  
WILLIAM L. HANLEY  
1639

Office of County Surveyor..... County of..... Baker.....  
 State of Oregon....., I hereby certify that the within instrument was filed in this office  
 for record on the 16 day of Oct., 1980  
 ..... by .....  
 (COUNTY OFFICIAL) (DEPUTY)