

CERTIFIED RECORD OF LAND CORNER MONUMENTATION


History of original corner establishment:

Corner established by W. B. Barr under GLO contract no. 503 dated May 23, 1884.

Surveyor General's records state:

Set granite rock 15 x 8 x 6 ins. 10 ins. in the ground for 1/4 sec. cor. marked 1/4 on the N side; from which

A fir 3 ins. diam bears S 62° E, 18 lks dist marked 1/4 S BT  
A fir 5 ins. diam bears N 70° E, 65 lks dist marked 1/4 S BT

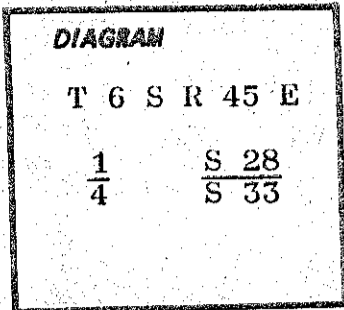

Description of corner evidence found:

Neither the original stone nor the original bearing trees were found.  
Found the following mineral survey corners from which are the nearest ties to the 1/4 sec. cor.

Corner no. 1, Florence Lode, Sur. no. 765 and Corner no. 2, Florence Lode which is identical with Cor. no. 7, Sur. no. 313, Prescott Lode.

Description of monument and accessories established to perpetuate the original location of this corner:

At the proportioned corner location set a 2½ inch brass cap on a 2 inch iron pipe, 31 inches long, and projecting 4 inches out of the ground with a surrounding rock mound.

Brass cap marked thus: T 6 S R 45 E

$\frac{1}{4}$  •  $\frac{S 28}{S 33}$

ORLS 1639  
1980

New bearing trees:

A fir 10 ins diam bears S 48° W, 17.7 feet marked 1/4 S 33 BT  
A fir 16 ins diam bears N 85° E, 13.7 feet marked 1/4 S 28 BT

Each new bearing tree has a brass washer marked PLS 1639 nailed flush with BT blaze and has a 6 inch band of red paint above upper blaze.

I hereby certify that this corner was properly re-established by me on Oct. 14, 1980, and witnessed by Jim DeMastus.

REGISTERED  
PROFESSIONAL  
LAND SURVEYOR

*William L Hanley*

OREGON  
JULY 14, 1978  
WILLIAM L. HANLEY  
1639

Office of County Surveyor County of Baker  
State of Oregon, I hereby certify that the within instrument was filed in this office  
for record on the 16 day of Oct, 1980  
by \_\_\_\_\_  
(COUNTY OFFICIAL) (DEPUTY)