


CERTIFIED RECORD OF LAND CORNER MONUMENTATION

History of original corner establishment:

Corner established this survey.

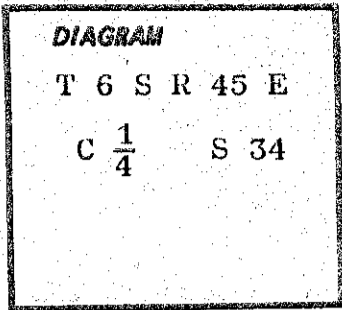

Description of corner evidence found:

None

Description of monument and accessories I established to perpetuate the original location of this corner:

At calculated corner location set a 2½ inch brass cap on a 2 inch iron pipe, 31 inches long, and projecting 6 inches out of the ground with a surrounding rock mound.

Brass cap marked thus: T 6 S R 45 E

C $\frac{1}{4}$ • S 34

ORLS 1639
1980

New bearing trees:

A pine 6 inches diam. bears S 07° W, 35.0 feet marked C 1/4 S 34 BT
A fir 12 inches diam. bears N 56° W, 18.9 feet marked C 1/4 S 34 BT

Each new bearing tree has a brass washer marked PLS 1639 nailed flush with BT blaze and has a 6 inch band red paint above upper blaze

I hereby certify that this corner monument was properly established by me on Oct. 15, 1980, and witnessed by Jim DeMastus.

REGISTERED PROFESSIONAL LAND SURVEYOR

William L. Hanley

OREGON JULY 14, 1978 WILLIAM L. HANLEY 1639
--

Office of County Surveyor..... County of... Baker.....
State of... Oregon..... I hereby certify that the within instrument was filed in this office
for record on the 16... day of... Oct....., 1980

..... by

(COUNTY OFFICIAL)

(DEPUTY)

Form R6-7100-51 (9/71)

FILED Oct. 16, 1980
BAKER COUNTY SURVEYOR
SURVEY NO. 645-21