

CERTIFIED RECORD OF LAND CORNER MONUMENTATION


History of original corner establishment:

Corner established by Henry W. Cooke, U S Deputy Mineral Surveyor, on June 14, 1887.

Surveyor General's records state:

Set a post 4½ feet long 4 ins square in a mound of stone marked Cor No 1 R J M C Sur No 10 on NW face of post from which:

A fir 12 ins dia bears S 78° E, 24 ft dist marked Cor No 1 R J M C Sur No 10 BT.

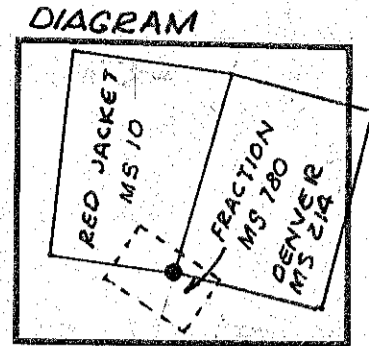

Description of corner evidence found:

A fir 30 ins diam with visible scribe marks in partially healed blaze which has 9 ins of overgrowth for record bearing tree.

NOTE: This position located from the record field notes of the FRACTION (MS 780) LODE from which the accessory bearing trees to cor no 1 (NE) and cor no 2 (NW) were found, and the record intersection on the line between these corners and the East line of the RED JACKET LODE (MS 10)

Description of monument and accessories established to perpetuate the original location of this corner:

Set a 2½ inch brass cap on a 1 inch iron pipe, 31 inches long, and projecting 8 inches out of the ground with concrete encasement.

Brass cap marked thus: 1-RJ-10
4-D- 214
1981
ORLS 1639

I hereby certify that the above described corner monument was properly re-established by me on October 20, 1981, and witnessed by Pat Leigh and Terry Vaughn.

REGISTERED
PROFESSIONAL
LAND SURVEYOR

William L. Hanley

OREGON
JULY 14, 1978
WILLIAM L. HANLEY
1639

Office of.....County...Surveyor..... County of.....Baker.....
State of.....Oregon....., I hereby certify that the within instrument was filed in this office
for record on the.....20..... day of.....October....., 19..81
.....James D. Hanley..... by *William L. Hanley*.....
(COUNTY OFFICIAL) (DEPUTY)

Form R6-7100-57 (9/71)

FILED Oct 20, 1981
BAKER COUNTY SURVEYOR
SURVEY NO. 6-45-25