


CERTIFIED RECORD OF LAND CORNER MONUMENTATION

History of original corner establishment:

Corner originally established by W.B. Barr under GLO contract No 443, dated May 29, 1882. Surveyor General record states: Set basalt rock 15x8x5 ins 10 inches in ground for corner to Sec 1,2,35,36 marked with 1 notch in the East and 5 notches on the West sides, from which a fir 10 in diam bears N65°E 25 lks dist marked T6SR45ES36BT a fir 8 in diam bears N45°W 34 lks dist marked T6SR45ES35BT a fir 16 in diam bears S65°W 50 lks dist marked T7SR45ES2BT a tamarack 14 in diam bears S27°E 19 lks dist marked T7SR45ES1BT. Corner remonumented by Lester A. Fischer for the BLM under U.S. Survey Group No. 350 dated August 22, 1974. Official record states in part: The corner position was determined from the record bearing and distance from the remains of the Southeast and Southwest BTs. Set an iron post with brass cap from which: A subalpine fir 8 in diam bears N83°E 47 lks dist marked T6S R45E S36 BT A white fir 8 in diam bears S22°E 23 lks dist marked T7S R45E S1 BT A lodgepole pine 8 in diam bears N78°W 11 lks dist marked T6S R45E S35 BT. No other trees available.

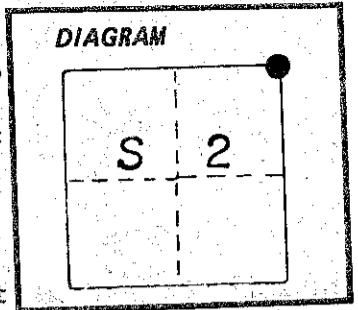

Description of corner evidence found:

Found standard BLM brass cap marked as shown below

Found all BTs taken by the BLM live and vigorous

Description of monument and accessories I established to perpetuate the original location of this corner:

From the above described monument:

NEW BT

A 20 in diam white fir bears S13°W, 87.3 feet marked T7S R45E S2 BT

Set steel fence post approximately 5 feet North with 54-4 sign attached

Corner updated November 21, 1981

Witnesses: Greg Blackman and Rick Robinson


**I hereby certify this corner was re-established as hereon described on the date written above**

I used a steel tape and magnetic compass in the establishment of accessories I used 20° East magnetic declination, and distance to the new BT is to the center of the tree. I placed a brass washer marked OPLS 644 by the BT blaze on the new BT

**REGISTERED  
PROFESSIONAL  
LAND SURVEYOR**

*Duane I. Griffith*

OREGON  
JULY 10, 1964  
**DUANE I. GRIFFITH**  
644

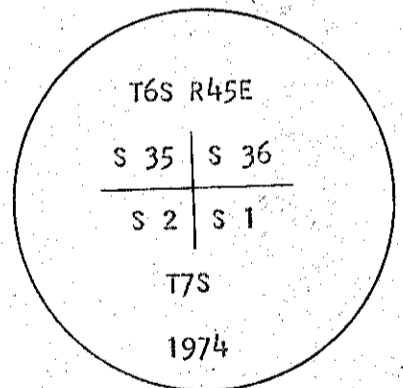

Office of..... County of.....

State of....., I hereby certify that the within instrument was filed in this office for record on the..... day of....., 19.....

..... by .....  
(COUNTY OFFICIAL) (DEPUTY)