


CERTIFIED RECORD OF LAND CORNER MONUMENTATION

History of original corner establishment:

Corner not previously established

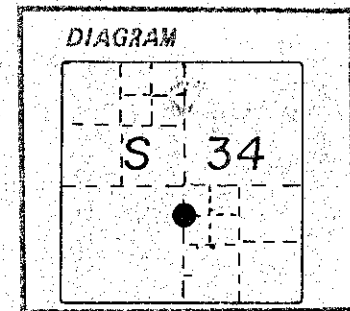

Description of corner evidence found:

NONE

Description of monument and accessories I established to perpetuate the original location of this corner:

At corner position I set a 2 1/2" x 30" iron pipe with brass cap marked as shown 28 inches in the ground from which:

NEW BTs

A 12 in diam white fir bears N75°E 44.3 feet marked CNS 1/64 S34 BT
A 20 in diam red fir bears S10°E 18.7 feet marked CNS 1/64 S34 BT

Raised mound of stone around monument
Set steel fence post approximately 5 feet Westerly with 54-2 sign and approximately 5 feet Southerly with 54-2 and 54-9 signs attached

Corner set October 4, 1982


Witnesses: Greg Blackman, Rick Robinson and Ray Crapo
See survey dated December, 1982

REGISTERED PROFESSIONAL LAND SURVEYOR

Handwritten signature of Duane I. Griffith

OREGON JULY 10, 1984 DUANE I. GRIFFITH 644

I hereby certify this corner was re-established as hereon described on the date written above

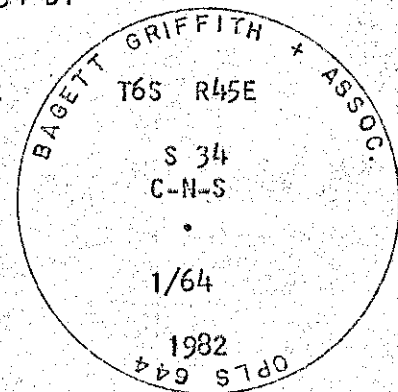

I used a steel tape and magnetic compass in the establishment of accessories. I used 20° East magnetic declination, and distances to the new BTs are to the center of the tree. I placed a brass washer marked OPLS 644 by the BT blaze of new BTs.

Office of..... County of.....

State of....., I hereby certify that the within instrument was filed in this office for record on the..... day of....., 19.....

..... by (COUNTY OFFICIAL) (DEPUTY)