


CERTIFIED RECORD OF LAND CORNER MONUMENTATION

History of original corner establishment:
Corner not previously established

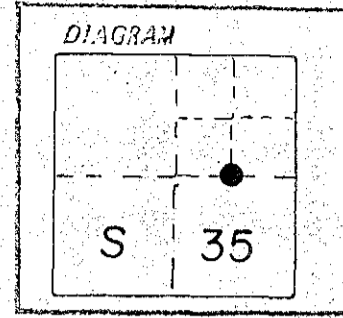

Description of corner evidence found:
NONE

Description of monument and accessories I established to perpetuate the original location of this corner:


At corner position I set a 2 1/2" x 30" aluminum pipe with aluminum cap marked as shown 28 inches in the ground from which:

NEW BTs

A 32 in diam spruce bears N85°E 125.0 feet marked CE1/16 S35 BT
A 12 in diam spruce bears S67°E 160.0 feet marked CE1/16 S35 BT

Set steel fence post approximately 5 feet westerly with 54-2 sign and approximately 5 feet Northerly with 54-2 and 54-9 sign attached

Corner set October 10, 1982
Witnesses: Rick Robinson, Greg Blackman and Ray Crapo
See survey dated December 1982

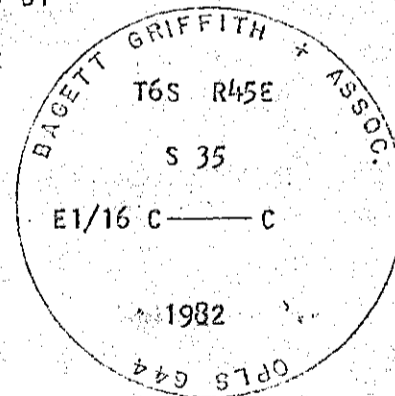

REGISTERED
PROFESSIONAL
LAND SURVEYOR

Signature of Duane I. Griffith

OREGON
JULY 10, 1954
DUANE I. GRIFFITH
644

I hereby certify this corner was re-established as hereon described on the date written above

I used a steel tape and magnetic compass in the establishment of accessories. I used 20° East magnetic declination, and distances to the new BTs are to the center of the tree. I placed a brass washer marked OPLS 644 by the BT blaze of new BTs.

Office of..... County of.....
State of....., I hereby certify that the within instrument was filed in this office for record on the..... day of....., 19.....
..... by.....
(COUNTY OFFICIAL) (DEPUTY)

Form R6-7100-57 (9/71)

FILED Sept 16, 1983
BAKER COUNTY SURVEYOR
SURVEY NO. 6-45-40

29 ✓