


CERTIFIED RECORD OF LAND CORNER MONUMENTATION

History of original corner establishment:

Corner not previously established

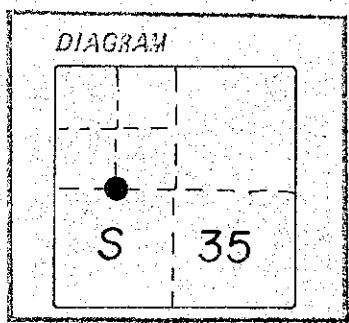

Description of corner evidence found:

NONE

Description of monument and accessories I established to perpetuate the original location of this corner:

At corner position I set a 2 $\frac{1}{2}$ "x30" aluminum pipe with aluminum cap marked as shown 28 inches in the ground from which:

NEW BTs


A 22 in diam white fir bears N88°E, 12.4 feet marked CW1/16 S35 BT
A 12 in diam white fir bears S71°W, 37.2 feet marked CW1/16 S35 BT

Set a steel fence post approximately 5 feet North with 54-2 sign and approximately 5 feet Easterly with 54-2 and 54-9 sign attached

Corner set October 10, 1982


Witnesses: Greg Blackman, Rick Robinson and Ray Crapo

See survey dated December 1982

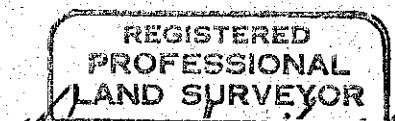

DUANE I. GRIFFITH
644

I hereby certify this corner was re-established as herein described on the date written above

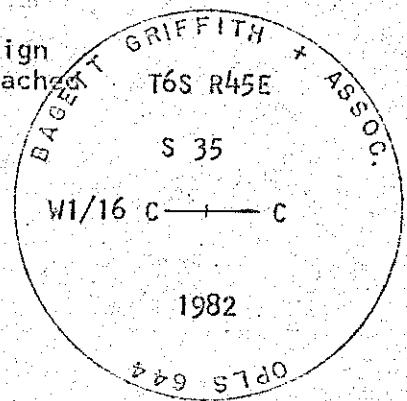

I used a steel tape and magnetic compass in the establishment of accessories. I used 20° East magnetic declination, and distances to the new BTs are to the center of the tree. I placed a brass washer marked OPLS 644 by the BT blaze of new BTs.

Office of..... County of.....

State of....., I hereby certify that the within instrument was filed in this office for record on the..... day of....., 19.....

(COUNTY OFFICIAL)

(DEPUTY)

Form R6-7100-57 (3/71)

FILED Sept 16, 1983

BAKER COUNTY SURVEYOR

SURVEY NO. 6-45-42

31 ✓