


CERTIFIED RECORD OF LAND CORNER MONUMENTATION

History of original corner establishment:
Corner not previously established

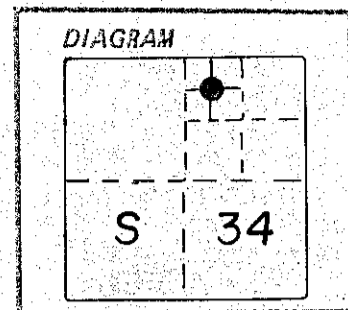

Description of corner evidence found:

NONE

Description of monument and accessories I established to perpetuate the original location of this corner:

At corner position, I set a 2 1/2"x30" iron pipe with brass cap marked as shown, 28 inches in the ground, from which:

- A 8 in diam white fir bears N23°E 21.7 feet marked NWNE 1/64 S34 BT
- A 6 in diam white fir bears N52°W 30.1 feet marked X BT

Set a steel fence post approximately 5 feet Westerly with 54-2 sign and approximately 5 feet Southerly with 54-2 and 54-9 sign attached

Corner set October 4, 1982

Witnesses: Greg Blackman, Rick Robinson and Ray Crapo


See survey dated December, 1982

I hereby certify this corner was re-established as hereon described on the data written above

REGISTERED PROFESSIONAL LAND SURVEYOR

Duane I. Griffith

OREGON
JULY 10, 1964
DUANE I. GRIFFITH
644

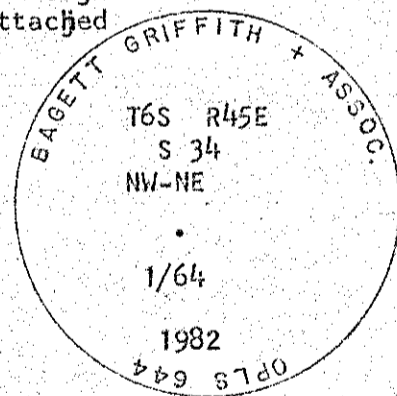

I used a steel tape and magnetic compass in the establishment of accessories. I used 20° East magnetic declination, and distances to the new BTs are to the center of the tree. I placed a brass washer marked OPLS 644 by the BT blaze of new BTs.

Office of..... County of.....

State of....., I hereby certify that the within instrument was filed in this office for record on the..... day of....., 19.....

..... by
(COUNTY OFFICIAL) (DEPUTY)