


CERTIFIED RECORD OF LAND CORNER MONUMENTATION

History of original corner establishment:  
Corner not previously established

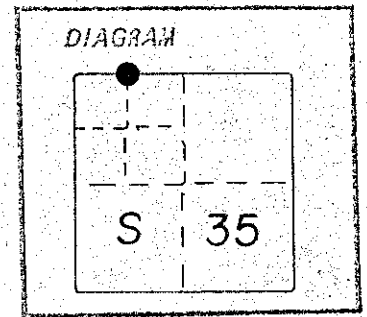

Description of corner evidence found:  
NONE

Description of monument and accessories I established to perpetuate the original location of this corner:  
At corner position I set a 2 1/2"x30" aluminum pipe with aluminum cap marked as shown, 28 inches in the ground, from which:

NEW BTs


- A 20 in diam white fir bears N45°E, 16.5 feet marked W1/16 S26 BT
- A 12 in diam red fir bears S84°E, 22.1 feet marked W1/16 S35 BT

Raised mound of stone around monument

Set steel fence post approximately 5 feet Easterly with 54-2 sign and approximately 5 feet Southerly with 54-2 and 54-9 sign attached

Corner set October 10, 1982

Witnesses: Greg Blackman, Rick Robinson and Ray Crapo  
See survey dated December, 1982

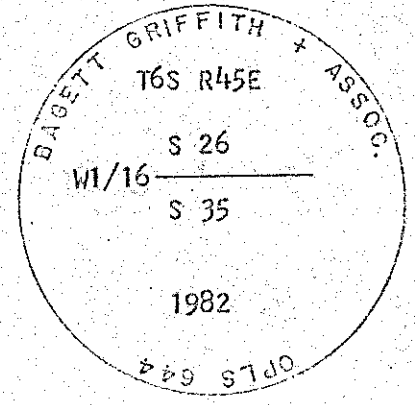

REGISTERED PROFESSIONAL LAND SURVEYOR

*Signature of Duane I. Griffith*

OREGON  
JULY 10, 1964  
DUANE I. GRIFFITH  
644

I hereby certify this corner was re-established as hereon described on the date written above

I used a steel tape and magnetic compass in the establishment of accessories. I used 20° East magnetic declination, and distances to the new BTs are to the center of the tree. I placed a brass washer marked OPLS 644 by the BT blaze of new BTs.

Office of..... County of.....  
State of..... I hereby certify that the within instrument was filed in this office for record on the..... day of....., 19.....  
..... by .....  
(COUNTY OFFICIAL) (DEPUTY)