


CERTIFIED RECORD OF LAND CORNER MONUMENTATION

History of original corner establishment:

Corner originally established by William L. Hanley, Survey Number 6-45-13. Official record states:

Set 2 1/2 inch brass cap on a 2 inch iron pipe from which:

- A spruce 16 inches diam bears N5°W 19.3 feet marked C 1/4 S27 BT
- A fir 8 inches diam bears S63°E 45.8 feet marked C 1/4 S27 BT

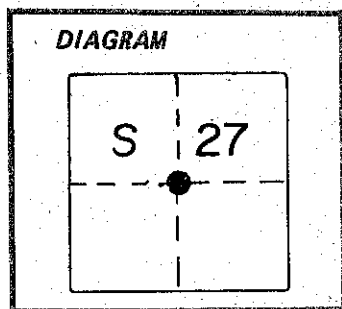

Description of corner evidence found:

Found brass cap marked as shown below

Found 8 in diam fir N63°E 45.8 feet live, not vigorous, scribes visible

Found 16 in diam spruce N5°W 19.3 feet, live and vigorous, scribes visible

Description of monument and accessories I established to perpetuate the original location of this corner:

From the above described monument:

NEW BT

A 16 in diam white fir bears S88°W, 107.6 feet marked C 1/4 S27 BT

Set steel fence post approximately 5 feet Southerly with 54-9 sign attached

Corner updated September 25, 1982


Witness: Rick Robinson

See survey dated December, 1982

REGISTERED
PROFESSIONAL
LAND SURVEYOR

OREGON
JULY 10, 1964
DUANE I. GRIFFITH
644

I hereby certify this corner was re-established as hereon described on the date written above

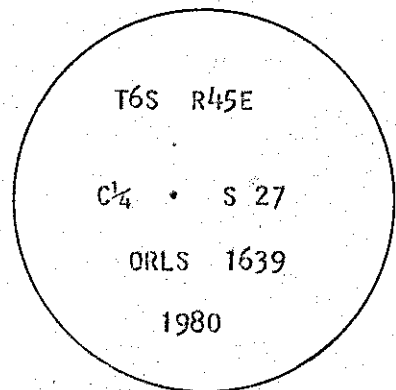

I used a steel tape and magnetic compass in the establishment of accessories. I used 20° East magnetic declination, and distances to the new BTs are to the center of the tree. I placed a brass washer marked OPLS 644 by the BT blaze of new BTs.

Office of..... County of.....

State of..... I hereby certify that the within instrument was filed in this office for record on the..... day of....., 19.....

..... by (COUNTY OFFICIAL) (DEPUTY)