


CERTIFIED RECORD OF LAND CORNER MONUMENTATION

History of original corner establishment:

Corner originally established by W.B. Barr under GLO contract No. 503, dated May 23, 1884. Surveyor General record states;
Set granite rock 22x12x8 ins 17 inches in ground for cor to Secs 20,21,28+29 marked with 2 notches on the S + 4 notches on the E edges from which:

A spruce 36 in diam bears N76°E 75 lks dist marked T6S R45E S21 BT
A fir 4 in diam bears N82°W 27 lks dist marked T6S R45E S20 BT
A spruce 36 in diam bears S45°W 56 lks dist marked T6S R45E S29 BT
No other trees within limits raised mound of rock alongside

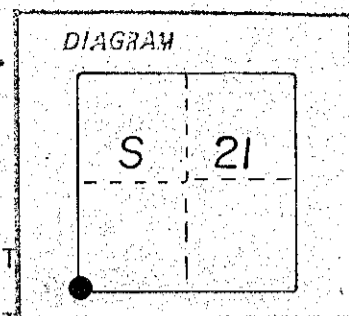

Description of corner evidence found:

Found granite rock, call size in mound of stone with marks visible

Found 36 in diam spruce down and rotted, scribes visible, bears N70°E 32.0 feet to base of tree

Found 36 in diam spruce snag, scribes visible, bears S54°W 53.8 feet to face of blaze

Description of monument and accessories I established to perpetuate the original location of this corner:


In place of stone I set a 2 1/2"x30" aluminum pipe with aluminum cap marked as shown 20 inches in the ground, from which:

NEW BTs

A 14 in diam lodgepole pine bears N18°E 37.0 feet marked T6S R45E S21 BT
A 24 in diam lodgepole pine bears S75°E 226.5 feet marked T6S R45E S28 BT
A 22 in diam double bole lodgepole pine bears S9°W 113.7 feet marked T6S R45E S29 BT
A 10 in diam double bole lodgepole pine bears N42°W 24.5 feet marked T6S R45E S20 BT

Raised mound of stone around monument
Buried stone South and alongside monument

Set steel fence post approximately 5 feet Southerly with 54-4 sign attached
Corner set August 31, 1982
Witness: Rick Robinson

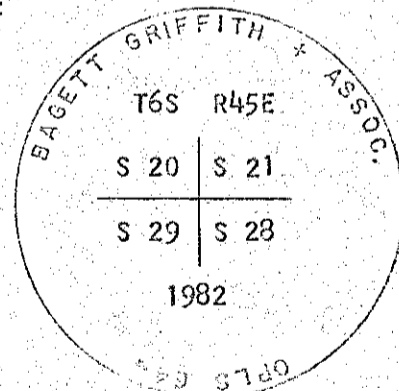

I hereby certify this corner was re-established as hereon described on the date written above

I used a steel tape and magnetic compass in the establishment of accessories. I used 20° East magnetic declination, and distances to the new BTs are to the center of the tree. I placed a brass washer marked OPLS 644 by the BT blaze of new BTs.

REGISTERED PROFESSIONAL LAND SURVEYOR

OREGON
JULY 10, 1984
DUANE I. GRIFFITH
644

Office of..... County of.....
State of....., I hereby certify that the within instrument was filed in this office for record on the..... day of....., 19.....
..... by

(COUNTY OFFICIAL)

(DEPUTY)

Form R6-7100-57 (9/71)

FILED Sept 16 1983
BAKER COUNTY SURVEYOR
SURVEY NO. 6-45-59

12540-733-376

48