


CERTIFIED RECORD OF LAND CORNER MONUMENTATION

History of original corner establishment:

Corner originally established by W.B. Barr under GLO contract No. 503, dated May 23, 1884. Surveyor General record states;

Set granite rock 15x12x7 ins 10 inches in ground for cor to Secs 15, 16, 21, +22 marked with 3 notches on the S + E edges from which;

- A fir 5 in diam bears N88°E 33 lks dist marked T6S R45E S15 BT
- A fir 15 in diam bears N10°W 30 lks dist marked T6S R45E S16 BT
- A fir 10 in diam bears S70°W 66 lks dist marked T6S R45E S21 BT
- A fir 15 in diam bears S4°E 40 lks dist marked T6S R45E S22 BT

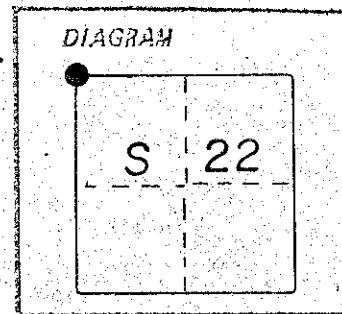

Description of corner evidence found:

- Found Southeast BT, now a 16 in diam red fir, live and vigorous, scribes visible, bears S10°E, 26.4 feet
- Found Southwest BT, now a 14 in diam red fir, live and vigorous, scribes visible, bears S51°W, 43.6 feet
- Found Northwest BT now a 16 in diam red fir live and vigorous, scribes visible, bears N17°W, 19.8 feet

Description of monument and accessories I established to perpetuate the original location of this corner:


At corner position I set a 5/8"x12" spike securely into rock. Corner position falls on very steep hillside, I therefore set a witness corner at a point on the section line between sections 15 and 22 (N88°26'54"E, 58.53 feet from true corner position), witness corner being a 2 1/2"x30" iron pipe with brass cap marked as shown, 20 inches in the ground from which:

WITNESS CORNER BTs

- A 10 in diam alpine fir bears North 49.3 feet marked X BT
- A 14 in diam alpine fir bears S57°E 11.3 feet marked X BT
- A 20 in diam red fir bears S25°W 24.5 feet marked X BT
- A 10 in diam alpine fir bears N27°W 41.0 feet marked X BT

- Raised mound of stone around monument
- Set steel fence post approximately 5 feet West with 54-4 sign attached
- Corner set August 29, 1982

Witnesses: Greg Blackman, Rick Robinson, Ray Crapo  
See survey dated December, 1982

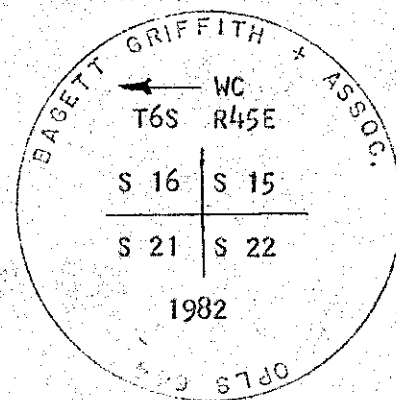

**REGISTERED PROFESSIONAL LAND SURVEYOR**

*Duane I. Griffith*

OREGON  
JULY 10, 1964  
**DUANE I. GRIFFITH**  
644

**I hereby certify this corner was re-established as hereon described on the date written above**

I used a steel tape and magnetic compass in the establishment of accessories. I used 20° East magnetic declination, and distances to the new BTs are to the center of the tree. I placed a brass washer marked OPLS 644 by the BT blaze of new BTs.

Office of..... County of.....  
State of....., I hereby certify that the within instrument was filed in this office for record on the..... day of....., 19.....  
..... by .....

(COUNTY OFFICIAL)

(DEPUTY)

Form R6-7100-57 (9/71)

FILED Sept 16, 1983  
BAKER COUNTY SURVEYOR  
SURVEY NO. 6-45-70

60 ✓