


CERTIFIED RECORD OF LAND CORNER MONUMENTATION

History of original corner establishment:  
 Corner originally established by W.B. Barr under GLO contract No. 503, dated May 23, 1884. Surveyor General record states;

A basalt rock in place for 1/4 sec corner marked with a cross + on top and 1/4 on the W side from which;

A fir 10 in diam bears N30°W 7 lks dist marked 1/4 S BT  
 A fir 6 in diam bears N65°E 5 lks dist marked 1/4 S BT

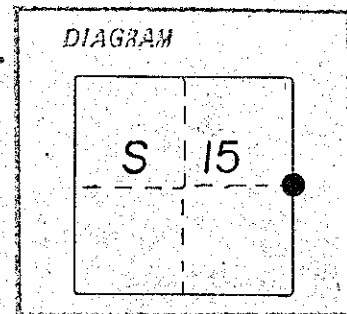

Description of corner evidence found:

Found 30''x18'' basalt stone in place 8 inches above ground marked with + on top and 1/4 on the West face

No trees remaining

Description of monument and accessories I established to perpetuate the original location of this corner:

From the above described corner monument:

New BTs


A 20 in diam white fir bears N34°E 62.4 feet marked 1/4 S14 BT  
 A 20 in diam tamarack bears N77°W 6.8 feet marked 1/4 S15 BT

Set a 2 1/2''x30'' aluminum pipe with aluminum cap marked as shown:  
 22 inches in the ground, with mound of stone around pipe,  
 5.00 feet Northerly on the section line (N2°43'28''W)

Set steel fence post approximately 5 feet Southerly of corner with 54-4 sign attached

Corner set September 1, 1982

Witnesses: Rick Robinson and Russ Hiatt

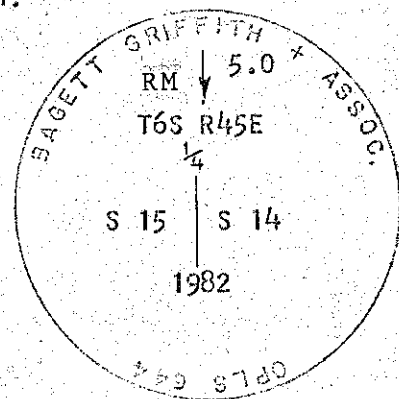

**I hereby certify this corner was re-established as hereon described on the date written above**

**REGISTERED PROFESSIONAL LAND SURVEYOR**

*Duane I. Griffith*

**OREGON JULY 10, 1964 DUANE I. GRIFFITH 644**

I used a steel tape and magnetic compass in the establishment of accessories. I used 20° East magnetic declination, and distances to the new BTs are to the center of the tree. I placed a brass washer marked OPLS 644 by the BT blaze of new BTs.

Office of..... County of.....  
 State of....., I hereby certify that the within instrument was filed in this office for record on the..... day of....., 19.....  
 ..... by .....  
 (COUNTY OFFICIAL) (DEPUTY)

Form R6-7100-57 (9/71)

FILED Sept 16 1983  
 BAKER COUNTY SURVEYOR  
 SURVEY NO. 6-45-74

65 ✓