


CERTIFIED RECORD OF LAND CORNER MONUMENTATION

History of original corner establishment:  
 Corner originally established by W.B. Barr under GLO contract No. 503, dated May 23, 1884. Surveyor General record states:

Set granite rock 14x10x6 ins 10 inches in ground for cor to Secs 10, 11, 14+15 marked with 4 notches on the S + 2 notches on the E edges from which:

A fir 6 in diam bears S38°E 150 lks dist marked T6S R45E S14 BT

No other trees within limits raised mound of rock alongside

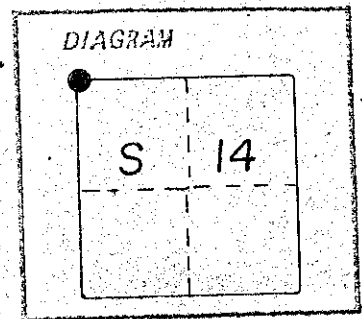

Description of corner evidence found:

Found marked stone, call size, in mound of stone

Found Southeast BT, now a 2 1/2 in diam fir, bears S45°E 89.8 feet from stone, living, scribes visible, chopped out

Description of monument and accessories I established to perpetuate the original location of this corner:

In place of stone I set a 2 1/2"x30" aluminum pipe with aluminum cap marked as shown 18 inches in the ground from which:

NEW BTs

A 18 in diam spruce bears N11°E 80.5 feet marked T6S R45E S11 BT

A 14 in diam spruce bears S44°E 79.5 feet marked T6S R45E S14 BT

A 12 in diam spruce bears S33°W 66.3 feet marked T6S R45E S15 BT

A 16 in diam spruce bears N29°W 121.5 feet marked T6S R45E S10 BT

Buried stone East and alongside monument

Raised mound of stone around monument


Set steel fence post approximately 5 feet

Southerly with 54-4 sign attached

Corner set August 17, 1982

Witness: Rick Robinson

**I hereby certify this corner was re-established as hereon described on the date written above**

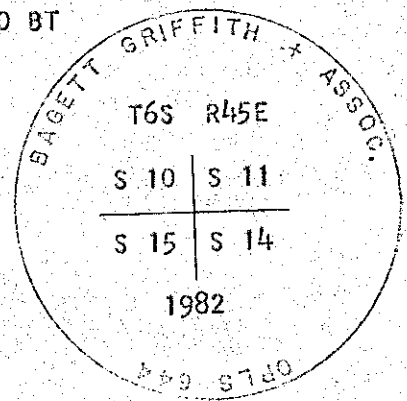

**REGISTERED PROFESSIONAL LAND SURVEYOR**

*Duane I. Griffith*

OREGON  
 JULY 10, 1964  
**DUANE I. GRIFFITH**  
 644

I used a steel tape and magnetic compass in the establishment of accessories. I used 20° East magnetic declination, and distances to the new BTs are to the center of the tree. I placed a brass washer marked OPLS 644 by the BT blaze of new BTs.

Office of..... County of.....  
 State of....., I hereby certify that the within instrument was filed in this office  
 for record on the..... day of....., 19.....  
 ..... by .....  
 (COUNTY OFFICIAL) (DEPUTY)

Form RG-7100-57 (9/71)

FILED Sept 16 1983  
 BAKER COUNTY SURVEYOR  
 SURVEY NO. 6-45-75

66