


CERTIFIED RECORD OF LAND CORNER MONUMENTATION

History of original corner establishment:

Corner originally established by Arthur U. Rudd, Mineral Survey number 784, under instructions dated February 25, 1915. Official record states:

For corner number 2, Portland no. 1 lode, identical with corner number 1, Portland no. 2 lode, set a schist stone 24x12x8 inches, set 15 inches in the ground chiseled X at corner point and 2-P1-784 and 1-P2-784.

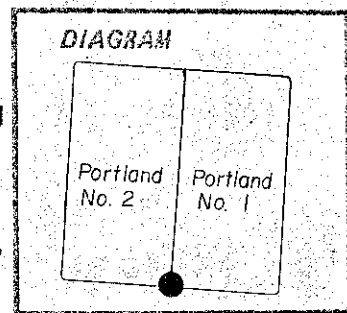

A fir tree 15 inches in diam. bears S5°W, 13 feet, blazed and scribed 2-P1-784 BT

A X chiseled on a schist cliff 30 feet high and 100 feet long bears North 12 feet, chiseled 1-P2-784 BR

The SE Cor of Sec 33 T6S R45E WM bears S24°08'E, 746.72 feet

Description of corner evidence found:

Found Southwest BT, live and vigorous, S50°W, 13 feet, now 20" dia, scribes visible

Found X on rock, North 12 feet

Description of monument and accessories I established to perpetuate the original location of this corner:

Corner falls on sheer rock face, I therefore set a witness corner, a 2 1/2"x30" aluminum pipe with aluminum cap marked as shown, 20 inches in the ground, N3°32'14"E, 26.80 feet from the true corner point, from which:

WITNESS CORNER BTs

12 in dia fir bears S55°W, 7.3 feet marked X BT


Raised mound of stone around monument

Set steel fence post approximately 5 feet North with 54-9 sign

Corner set September 8, 1982

Witnesses: Greg Blackman and Ray Crapo

See survey dated December, 1982

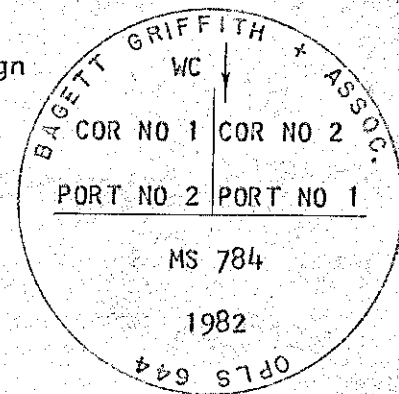

REGISTERED
PROFESSIONAL
LAND SURVEYOR

I hereby certify this corner was re-established as hereon described on the date written above

Duane I. Griffith

OREGON
JULY 10, 1964
DUANE I. GRIFFITH
644

I used a steel tape and magnetic compass in the establishment of accessories. I used 20° East magnetic declination, and distances to the new BTs are to the center of the tree. I placed a brass washer marked OPLS 644 by the BT blaze of new BTs.

Office of..... County of.....

State of..... I hereby certify that the within instrument was filed in this office

for record on the..... day of....., 19....

..... by

(COUNTY OFFICIAL)

(DEPUTY)

Form R6-7100-57 (9/71)

FILED Sept 16 1983
BAKER COUNTY SURVEYOR
SURVEY NO. 6-45-77

★ GPO—733-275

68 ✓