


CERTIFIED RECORD OF LAND CORNER MONUMENTATION

History of original corner establishment:

Corner originally established by Arthur U. Rudd, Mineral Survey No. 784, under instructions dated February 25, 1915. Official record states:

For corner no. 3, Portland no. 1 lode, identical with corner no. 4, Portland no. 2 lode, a schist stone 24x12x6 inches, set 15 inches in the ground chiseled X at corner point and 3-P1-784 and 4-P2-784

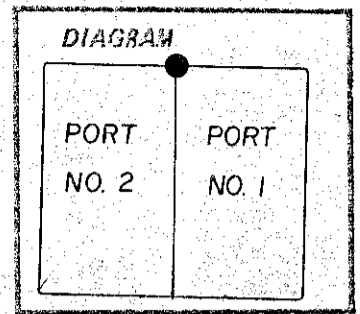

A fir tree 10 inches in diam. bears S30°E, 30 feet, blazed and scribed 3-P1-784 BT

A fir tree 14 inches in diam. bears S25°W, 10 feet, blazed and scribed 4-P2-784 BT

Description of corner evidence found:

Found marked stone in mound of stone

Found the Southeast BT, now a 21 in diam white fir, bears S19°E 25.7 feet, blaze evident, did not open

Description of monument and accessories I established to perpetuate the original location of this corner:

In place of stone, I set a 2 1/2"x30" iron pipe with brass cap marked as shown, 18 inches in the ground from which:

NEW BT

A 20 on diam red fir bears S44°W, 26.8 feet marked COR 4 P2 784 BT

Buried stone South and alongside of monument


Raised mound of stone around monument

Set steel fence post approximately 5 feet Easterly with 54-2 sign and approximately 5 feet Westerly with 54-2 and 54-9 signs attached

Corner set September 9, 1982

Witnesses: Greg Blackman and Ray Crapo

See survey dated December, 1982

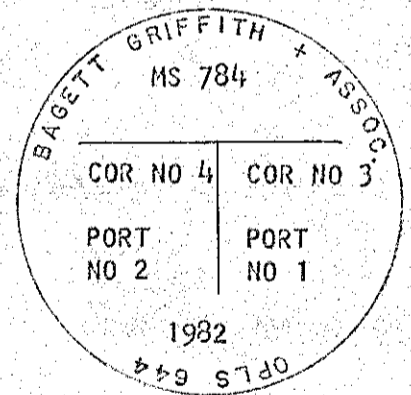

REGISTERED
PROFESSIONAL
LAND SURVEYOR

OREGON
JULY 10, 1984
DUANE I. GRIFFITH
644

I hereby certify this corner was re-established as hereon described on the date written above

I used a steel tape and magnetic compass in the establishment of accessories. I used 20° East magnetic declination, and distances to the new BTs are to the center of the tree. I placed a brass washer marked OPLS 644 by the BT blaze of new BTs.

Office of..... County of.....

State of....., I hereby certify that the within instrument was filed in this office for record on the..... day of....., 19.....

..... by

(COUNTY OFFICIAL)

(DEPUTY)

Form R6-7100-57 (9/71)

FILED Sept 16 1983
BAKER COUNTY SURVEYOR
SURVEY NO. 6-45-80

Y(280-709-276