

CERTIFIED RECORD OF LAND CORNER MONUMENTATION

History of original corner establishment:


Corner originally established by Arthur U. Rudd, Mineral Survey No. 784, under instructions dated February 25th 1915. Official record states:

For corner no. 4 Portland no. 1 lode, a basalt stone 24x12x10 ins set 15 inches in the ground, chiseled X at corner point and 4P1-784.

A fir tree 20 inches in diam. bears S70°W, 6 feet, blazed and scribed 4-P1-784 BT

A fir tree 20 inches in diam. bears N70°W, 27 feet, blazed and scribed 4-P1-784 BT

DIAGRAM

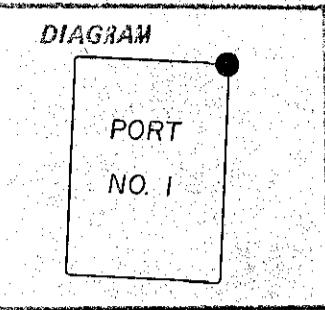

Description of corner evidence found:

Found marked stone, call size, in mound of stone

Found 36 in diam white fir S38°W, 8.0 feet, blaze evident, did not open, tree live and vigorous

Description of monument and accessories I established to perpetuate the original location of this corner:

In place of stone, I set a 2 $\frac{1}{2}$ "x30" iron pipe with brass cap marked as shown, 28 inches in the ground, from which:

NEW BT

A 10 in diam white fir bears S55°E, 50.3 feet marked COR 4 P1 784 BT


Buried stone South and alongside of monument
Raised mound of stone around monument

Set steel fence post approximately 5 feet Westerly with 54-2 sign and approximately 5 feet Southerly with 54-2 and 54-9 sign attached;

Corner set September 9, 1982

Witnesses: Greg Blackman and Ray Crapo

See survey dated December, 1982

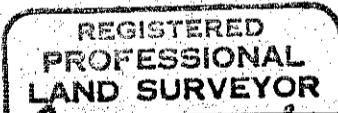

I hereby certify this corner was re-established as herein described on the date written above

Duane I. Griffith

I used a steel tape and magnetic compass in the establishment of accessories. I used 20° East magnetic declination, and distances to the new BTs are to the center of the tree. I placed a brass washer marked OPLS 6 $\frac{1}{4}$ by the BT blaze of new BTs.

Office of..... County of.....

State of..... I hereby certify that the within instrument was filed in this office for record on the..... day of....., 19.....

..... by (COURT OFFICIAL) (DEPUTY)

Form R6-7100-57 (9/71)

FILED Sept 16 1983

BAKER COUNTY SURVEYOR
SURVEY NO. 6-45-81

RCPO-733-276

572 ✓