


CERTIFIED RECORD OF LAND CORNER MONUMENTATION

History of original corner establishment:

Corner originally established by Felix Ed. Wormser, Mineral Survey number 799A, under instructions dated August 8, 1917. Official record states:

Corner no. 2, Columbia lode, on the steep south bank of Lost Horse creek, a tamarack post, 5 ft. long, 6 ins. square, set 2 1/2 ft. in the ground, with a mound of earth, scribed COL-2-799A

A white fir tree, 15 ins. dia. bears N65°26'W, 6.16 ft. blazed and scribed COL-2-799A BT

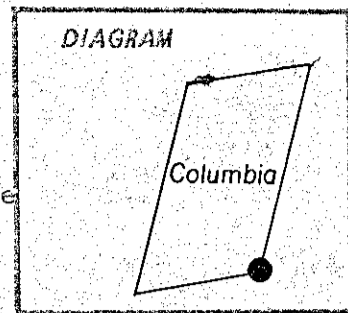

Description of corner evidence found:

Found a 36 in diam fir, scribes visible, live and vigorous, with mound of stone at record bearing and distance for the corner

Description of monument and accessories I established to perpetuate the original location of this corner:

At record bearing and distance from the found BT, and in the mound of stone, I set a 2 1/2"x30" iron pipe with brass cap marked as shown, 26 inches in the ground, from which;


NEW BT

A 13 in dia red fir bears S25°W 23.0 feet marked COR 2 COL 799A BT

Raised mound of stone around monument

Set steel fence post approximately 5 feet Northeasterly with 54-2 and 54-4 sign and approximately 5 feet Westerly with 54-2 sign attached

Corner set September 12, 1982  
Witnesses: Greg Blackman and Ray Crapo

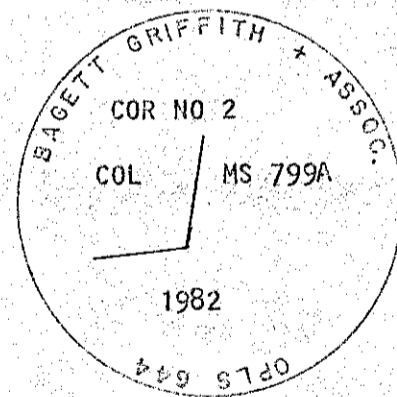

REGISTERED PROFESSIONAL LAND SURVEYOR

I hereby certify this corner was re-established as hereon described on the date written above

*Signature of Duane I. Griffith*

OREGON JULY 10, 1964 DUANE I. GRIFFITH 644

I used a steel tape and magnetic compass in the establishment of accessories. I used 20° East magnetic declination, and distances to the new BTs are to the center of the tree. I placed a brass washer marked OPLS 644 by the BT blaze of new BTs.

Office of..... County of.....  
State of....., I hereby certify that the within instrument was filed in this office for record on the..... day of....., 19.....  
..... by .....  
(COUNTY OFFICIAL) (DEPUTY)