


CERTIFIED RECORD OF LAND CORNER MONUMENTATION

History of original corner establishment:

Corner originally established by Felix Ed. Wormser, Mineral Survey number 799A, under instructions dated August 8, 1917. Official record states:

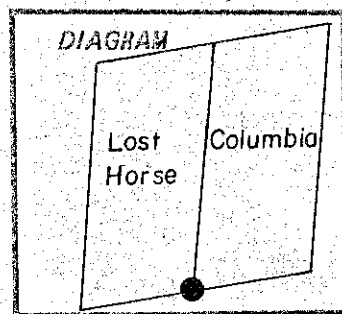

Corner no. 2 Lost Horse lode, identical with corner no. 3, Columbia lode, this survey, a tamarack post, 5 ft. long, 7 ins. square, set 2½ ft. in the ground, with a mound of earth, scribed LH-2-799A and COL-3-799A on sides facing respective claims.

A white fir tree, 21 ins. dia. bears N85°11'W, 25.1 ft. blazed and scribed, LH-2-799A BT
 A tamarack tree, 12 ins. dia. bears N34°44'E, 21.1 feet, blazed and scribed COL-3-799A BT

Description of corner evidence found:

Found the Northeast BT, alive and vigorous, tree is now a 15 in diam tamarack, record bearing and distance, scribes visible

Description of monument and accessories I established to perpetuate the original location of this corner:


At record bearing and distance, I set a 2½"x30" aluminum pipe with aluminum cap marked as shown, 28 inches in the ground, from which:

New BT
 A 8 in diam fir bears S64°E 26.6 feet marked COR 3 COL 799A BT

Set a steel fence post approximately 5 feet Westerly with 54-2 sign and approximately 5 feet Easterly with 54-2 and 54-4 sign attached

Corner set September 12, 1982
 Witnesses: Greg Blackman and Ray Crapo

I hereby certify this corner was re-established as hereon described on the date written above

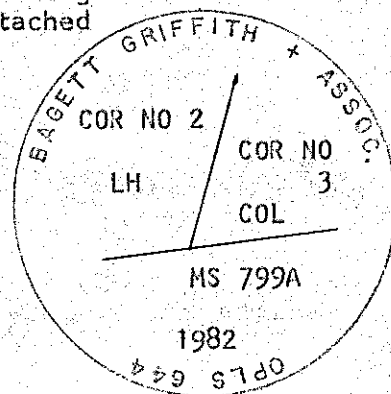

**REGISTERED
 PROFESSIONAL
 LAND SURVEYOR**

Duane I. Griffith

OREGON
 JULY 10, 1964
DUANE I. GRIFFITH
 644

I used a steel tape and magnetic compass in the establishment of accessories. I used 20° East magnetic declination, and distances to the new BTs are to the center of the tree. I placed a brass washer marked OPLS 644 by the BT blaze of new BTs.

Office of..... County of.....
 State of..... I hereby certify that the within instrument was filed in this office for record on the..... day of....., 19.....
 by
 (COUNTY OFFICIAL) (DEPUTY)