


CERTIFIED RECORD OF LAND CORNER MONUMENTATION

History of original corner establishment:

Corner originally established by Felix Ed. Wormser, Mineral Survey number 799A, under instructions dated August 8, 1917. Official record states:

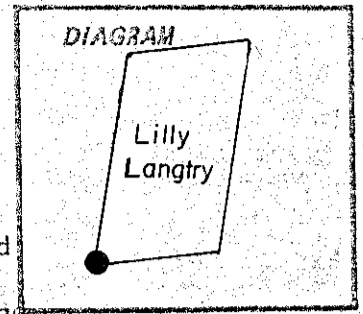

For corner number 3, Lilly Langtry lode, set a white fir post, 5 ft. long, 8 ins. square, set 2 1/2 ft. in the ground, with a mound of earth and stone, scribed LL-3-799A. A white fir tree, 10 ins. dia. bears S26°23'W, 19.5 ft. blazed and scribed LL-3-799A BT

Description of corner evidence found:

Found 20 in diam white fir stump Scribes visible

Description of monument and accessories I established to perpetuate the original location of this corner:


At record bearing and distance from the found BT, I set a 2 1/2"x30" aluminum pipe with aluminum cap marked as shown, 27" in the ground from which:

NEW BTs

A 10 in diam white fir bears N30°E, 48.3 feet, marked COR 3 LL 799A BT
A 20 in diam white fir bears N70°W, 48.7 feet, marked COR 3 LL 799A BT

Set steel fence post approximately 5 feet Westerly with 54-2 sign and approximately 5 feet Northerly with 54-2 and 54-4 sign attached

Corner set September 9, 1982
Witnesses: Greg Blackman and Ray Crapo

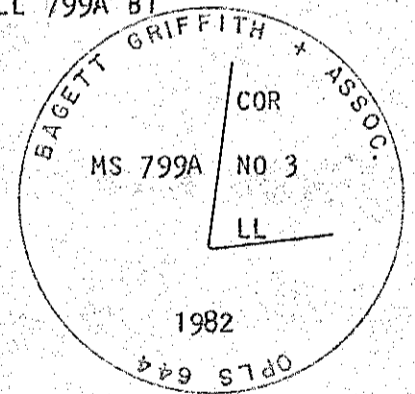

I hereby certify this corner was re-established as hereon described on the date written above

REGISTERED PROFESSIONAL LAND SURVEYOR

Duane I. Griffith

OREGON JULY 10, 1964 DUANE I. GRIFFITH 644

I used a steel tape and magnetic compass in the establishment of accessories. I used 20° East magnetic declination, and distances to the new BTs are to the center of the tree. I placed a brass washer marked OPLS 644 by the BT blaze of new BTs.

Office of..... County of.....
State of..... I hereby certify that the within instrument was filed in this office for record on the..... day of..... 19.....
..... by
(COUNTY OFFICIAL) (DEPUTY)