


CERTIFIED RECORD OF LAND CORNER MONUMENTATION

History of original corner establishment:

Corner originally established by Felix Ed. Wormser, Mineral Survey number 799B, under instructions dated August 8, 1917. Official record states:

For corner number 3, Eureka Millsite, set a tamarack post, 5 ft. long, 7 ins. square, set 2 1/2 ft. in the ground on the edge of a depression or pit, 350 ft. long, 50 to 90 feet wide, and 35 feet deep, with a mound of earth, scribed EMS-3-799B

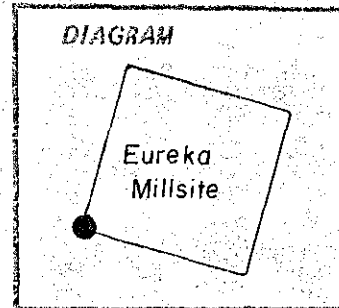

A white fir tree, 28 ins. dia. bears S68°38'E, 83.4 ft. blazed and scribed EMS-3-799B BT

Description of corner evidence found:

Found the Southeast BT, alive and vigorous, blaze evident, did not open, now a 36 in diam white fir tree

Description of monument and accessories I established to perpetuate the original location of this corner:

At record bearing and distance from the found BT, I set a 2 1/2"x30" iron pipe with brass cap marked as shown, 26 inches in the ground from which:

NEW BTs


A 16 in dia white fir bears S46°W, 27.1 feet marked COR 3 EMS 799B BT

Set steel fence post approximately 5 feet Northeasterly with 54-2 and 54-1 signs and approximately 5 feet Southwesterly with 54-2 sign attached

Corner set September 14, 1982

Witnesses: Greg Blackman and Ray Crapo

I hereby certify this corner was re-established as herein described on the date written above

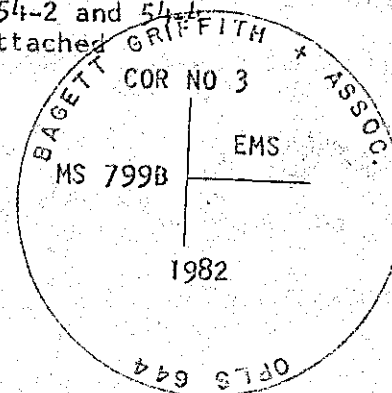

REGISTERED PROFESSIONAL LAND SURVEYOR

Duane I. Griffith
OREGON
JULY 10, 1964
DUANE I. GRIFFITH
644

I used a steel tape and magnetic compass in the establishment of accessories. I used 20° East magnetic declination, and distances to the new BTs are to the center of the tree. I placed a brass washer marked OPLS 644 by the BT blaze of new BTs.

Office of..... County of.....
State of....., I hereby certify that the within instrument was filed in this office
for record on the..... day of....., 19.....
..... by

(COUNTY OFFICIAL)

(DEPUTY)

Form R6-7100-57 (9/71)

FILED Sept 16 1983

BAKER COUNTY SURVEYOR
SURVEY NO. 6-45-89

800-793-275

80