

CERTIFIED RECORD OF LAND CORNER MONUMENTATION


History of original corner establishment:

Corner originally established by Arthur H. Rudd, Mineral Survey number 765, under instructions dated November 15, 1913. Official record states:

For corner number 4, a fir post, 4 inches square and 4 feet long set 18 inches in the ground scribed Cor No 4 Sur No 765 OGFox.

A fir tree 14 inches in diam bears N57°35'E, 30 feet, blazed and scribed Cor No 4 OGFox Sur No 765 BT

A fir tree 10 inches in diam bears S29°15'E 25.8 feet blazed and scribed Cor No 4 OGFox Sur No 765 BT

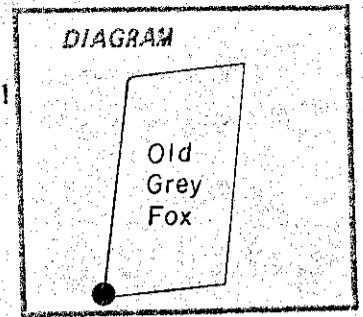

Description of corner evidence found:

Found Southerly BT, with healed blaze, opened and found scribes facing N29°E. I came out record distance on this bearing to establish the corner position. Found stump hole at record bearing and distance for other BT using the Northeast bearing to place the corner position

Description of monument and accessories I established to perpetuate the original location of this corner:


From the found bearing tree, At record distance, on the bearing described above I set a 2 1/2"x30" aluminum pipe with aluminum cap marked as shown, 28 inches in the ground from which:

NEW BTs

A 12 in diam white fir bears S50°W 25.9 feet marked COR 4 OGF 765 BT  
 A 20 in diam red fir bears N59°W 13.9 feet marked COR 4 OGF 765 BT

Set steel fence post approximately 5 feet Southeasterly with 54-4 and 54-2 sign attached

Corner set September 13, 1982  
 Witnesses: Rick Robinson

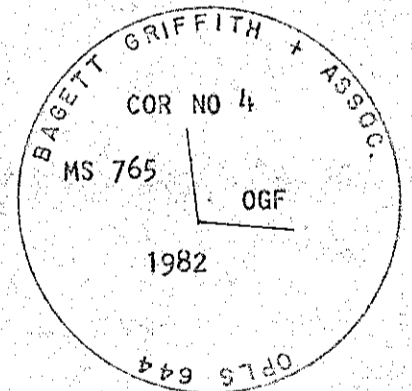

**I hereby certify this corner was re-established as hereon described on the date written above**

**REGISTERED  
 PROFESSIONAL  
 LAND SURVEYOR**

*Duane J. Griffith*

OREGON  
 JULY 10, 1964  
**DUANE J. GRIFFITH**  
 644

I used a steel tape and magnetic compass in the establishment of accessories. I used 20° East magnetic declination, and distances to the new BTs are to the center of the tree. I placed a brass washer marked OPLS 644 by the BT blaze of new BTs.

Office of..... County of.....  
 State of....., I hereby certify that the within instrument was filed in this office  
 for record on the..... day of....., 19.....  
 ..... by .....  
 (COUNTY OFFICIAL) (DEPUTY)

Form R6-7100-57 (9/71)

FILED Sept 16 1983  
 BAKER COUNTY SURVEYOR  
 SURVEY NO. 6-45-93

☆ GPO-793-275

BA ✓