


CERTIFIED RECORD OF LAND CORNER MONUMENTATION

History of original corner establishment:  
 Corner originally established by Arthur H. Rudd, Mineral Survey Number 780, under instructions dated June 23, 1914. Official Record states:

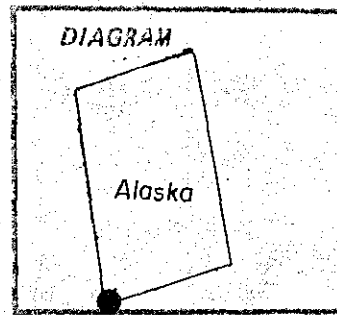

For corner number 4, Alaska lode, set a basalt stone 26X16X16 inches, set 15 inches in the ground, near top of Butte, chiseled X at corner point and 4-A-780 on E face.

A fir tree 20 inches in diam. bears S18°W 42.8 feet, blazed and scribed 4-A-780-BT

A tamarack tree, 16 inches in diam bears N54°10'E, 41 feet, blazed and scribed 4-A-780-BT

Description of corner evidence found:

Found piece of broken stone with + in small mound of stone near top of ridge,

Found Northeast BT, a 16 in diam tamarack, opened and found scribes (illegible) at record bearing and distance from stone

Description of monument and accessories I established to perpetuate the original location of this corner:

In place of stone, I set a 2 1/2"x30" iron pipe with brass cap marked as shown, 23 inches in the ground, from which:


NEW BTs

A 8 in diam white fir bears S87°E 29.1 feet marked COR 4 ALK 780 BT  
 A 16 in diam red fir bears S20°W 37.0 feet marked COR 4 ALK 780 BT

Buried stone South and alongside of monument  
 Raised mound of stone around monument

Set steel fencepost approximately 5 feet Northerly with 54-2 sign and approximately 5 feet Easterly with 54-2 and 54-4 sign attached

Corner set September 13, 1982  
 Witnesses: Greg Blackman, Rick Robinson and Ray Crapo

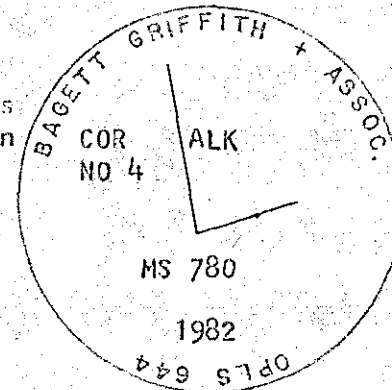

REGISTERED PROFESSIONAL LAND SURVEYOR

*Duane J. Griffith*

OREGON  
 JULY 10, 1964  
 DUANE J. GRIFFITH  
 644

**I hereby certify this corner was re-established as hereon described on the date written above**

I used a steel tape and magnetic compass in the establishment of accessories. I used 20° East magnetic declination, and distances to the new BTs are to the center of the tree. I placed a brass washer marked OPLS 644 by the BT blaze of new BTs.

Office of..... County of.....  
 State of....., I hereby certify that the within instrument was filed in this office for record on the..... day of....., 19.....  
 by..... (COUNTY OFFICIAL) (DEPUTY)

Form R6-7100-57 (9/71)

FILED Sept 16 1983  
 BAKER COUNTY SURVEYOR  
 SURVEY NO. 6-45-96

☆ GPO-705-276

87

✓