


CERTIFIED RECORD OF LAND CORNER MONUMENTATION

History of original corner establishment:

Corner originally established by Arthur H. Rudd, Mineral Survey number 780, under instructions dated June 23, 1914. Official record states:

For corner no. 3, Coup D'Or lode, on South boundary of Crescent lode (unsurveyed), set a fir post 5 inches square and 4 feet long set 18 inches in the ground, on timbered flat, with nail set at corner point and scribed Cor No 3, Coup D'Or, Sur 780

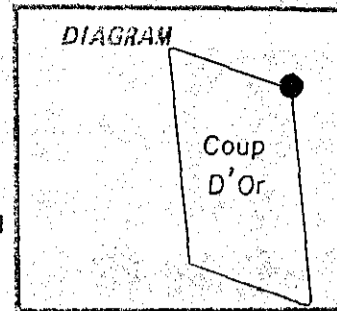

A fir tree 18 inches in diam bears S82°W, 18 feet blazed and scribed Cor No 3, Coup D'Or, Sur 780 BT

A fir tree 16 inches in diam. bears N58°W, 19 feet blazed and scribed Cor No 3, Coup D'Or Sur 780 BT

Description of corner evidence found:

Found both original BTs, described below,

Description of monument and accessories I established to perpetuate the original location of this corner:


At record bearing and distance from the found BTs, I set a 2 1/2"x30" iron pipe with brass cap marked as shown, 28 inches in the ground, from which:

ORIGINAL BTs (distances are to the face of existing blaze)

A 36 in diam white fir bears S82°W, 18.0 feet, live and vigorous, scribes visible
A 32 in diam white fir bears N58°W, 19.0 feet, live and vigorous, scribes visible

Set steel fence post approximately 5 feet Southeasterly with 54-2 sign and approximately 5 feet Southerly with 54-2 and 54-4 signs attached.

Corner set September 15, 1982
Witnesses: Rick Robinson and Ray Crapo
See survey dated December, 1982

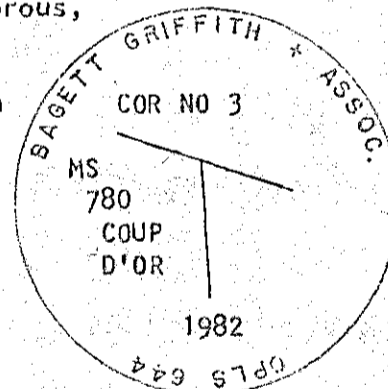

REGISTERED PROFESSIONAL LAND SURVEYOR

Signature of Duane I. Griffith

OREGON JULY 10, 1964 DUANE I. GRIFFITH 644

I hereby certify this corner was re-established as hereon described on the date written above

I used a steel tape and magnetic compass in the establishment of accessories. I used 20° East magnetic declination, and distances to the new BTs are to the center of the tree. I placed a brass washer marked UPLS 644 by the BT blaze of new BTs.

Office of..... County of.....
State of....., I hereby certify that the within instrument was filed in this office for record on the..... day of....., 19.....
..... by
(COUNTY OFFICIAL) (DEPUTY)

Form R6-7100-57 (9/71)

FILED Sept 16 1983
BAKER COUNTY SURVEYOR
SURVEY NO. 6-45-102

11C-0-723-275

93 ✓