


CERTIFIED RECORD OF LAND CORNER MONUMENTATION

History of original corner establishment:  
Corner not previously established

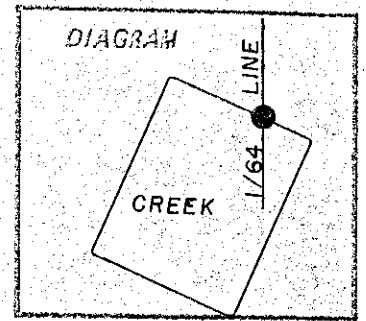

Description of corner evidence found:  
NONE


Description of monument and accessories I established to perpetuate the original location of this corner:

At the intersection of the North line of Creek lode, and the 1/64 line set a 2 1/2'x30" aluminum pipe with aluminum cap marked as shown, 30 inches in the ground from which:

- A 10 in diam red fir bears N12°E, 122.4 feet marked CR'K A BT
- A 6 in diam spruce bears S41°W, 17.7 feet marked X BT

Set steel fence post approximately 5 feet Northerly with 54-2 sign and approximately 5 feet Westerly with 54-2 and 54-4 signs attached

Corner set October 11, 1982  
Witnesses: Rick Robinson and Ray Crapo  
See survey dated December, 1982

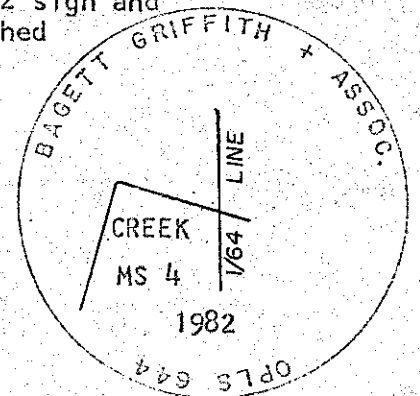

REGISTERED PROFESSIONAL LAND SURVEYOR

*Duane I. Griffith*

OREGON  
JULY 10, 1961  
DUANE I. GRIFFITH  
644

I hereby certify this corner was re-established as hereon described on the date written above

I used a steel tape and magnetic compass in the establishment of accessories. I used 20° East magnetic declination, and distances to the new BTs are to the center of the tree. I placed a brass washer marked OPLS 644 by the BT blaze of new BTs.

Office of..... County of.....  
State of..... I hereby certify that the within instrument was filed in this office for record on the..... day of....., 19.....  
..... by .....

(COUNTY OFFICIAL)

(DEPUTY)

Form RS-7109-57 (9/71)

FILED Sept 16 1983  
BAKER COUNTY SURVEYOR  
SURVEY NO. 6-45-116

108 ✓