


CERTIFIED RECORD OF LAND CORNER MONUMENTATION

History of original corner establishment:

Corner originally established by Arthur H. Rudd, Mineral Survey number 779, under instructions dated July 17, 1914. Official record states:

Corner no. 3, Autumn lode, on line 3-4 Manhattan lode of this survey. A basalt stone 24x16x4 inches, set 16 inches in the ground on hillside, 150 feet above Pine creek, chiseled X at corner point and 3-AU-779 on E face.

A fir tree 12 inches in diam. bears West, 5 feet, blazed and scribed 3-AU-779-BT
A fir tree 16 inches in diam. bears S80°E, 21 feet blazed and scribed 3-AU-779-BT

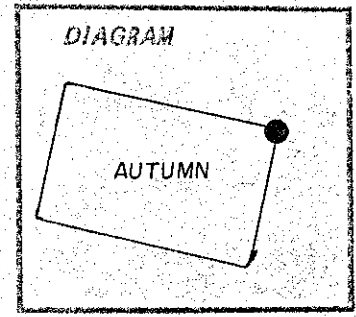

Description of corner evidence found:

Found Southeast BT, now a 30 in diam stump, scribes visible

Description of monument and accessories I established to perpetuate the original location of this corner:



At record bearing and distance from the found BT, I set a 2 1/2"x30" iron pipe with brass cap marked as shown, 24 inches in the ground from which:

NEW BTs
A 10 in diam white fir bears S40°E, 16.2 feet marked COR 3 AU 779 BT
A 14 in diam white fir bears S63°W, 16.0 feet marked X BT


Raised mound of stone around monument

Set steel fence post with 54-4 and 542 signs attached approximately 5 feet Northeasterly
Corner set September 25, 1982
Witness: Rick Robinson

See survey dated December, 1982

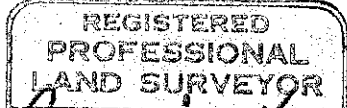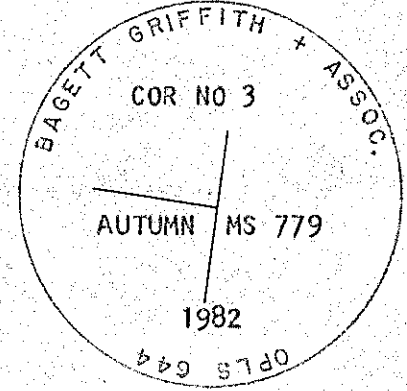

Duane J. Griffith

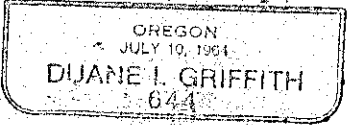

I hereby certify this corner was re-established as hereon described on the date written above

I used a steel tape and magnetic compass in the establishment of accessories. I used 20° East magnetic declination, and distances to the new BTs are to the center of the tree. I placed a brass washer marked OPLS 644 by the BT blaze of new BTs.

Office of..... County of.....
State of..... I hereby certify that the within instrument was filed in this office for record on the..... day of....., 19.....
..... by

(COUNTY OFFICIAL)

(DEPUTY)

Form RG-7100-57 (9/71)

FILED Sept 16 1983
BAKER COUNTY SURVEYOR
SURVEY NO. 6-45-119

CGPO-733-275

