


CERTIFIED RECORD OF LAND CORNER MONUMENTATION

History of original corner establishment:

Corner originally established by Henry W. Cooke, Mineral survey number 3, dated September 28, 1886. Official record states: The SW cor of claim at which point I set a post 5 ft. long and 4 ins square in a mound of stone marked COR NO 4 BMC SUR NO 3 A fir 12 ins dia bears S77°10'E 41 ft dist marked COR NO 4 BMC SUR NO 3 BT. A fir 10 ins dia bears S10°35'E 70 ft dist marked COR NO 4 BMC SUR NO 3 BT. Corner remonumented by Mineral Survey number 820 and Mineral survey number 779. MS 779 replaced the post with a stone which is further described in the official record of mineral survey number 820: Corner number 3, Crescent lode, identical with cor. no. 3 sur no. 779, artic lode and cor. no. 4, sur. no.3, Bruin lode, A schist stone 28x16x10 ins. set 6 ins in the ground with mound of stones, marked X at corner point and C-3-820, A-3-779, B-4-3, whence;  
 A fir tree 16 ins diam bears S89°30'E, 35.9 feet scribed C-3-820 A-3-779 B-4-3-BT  
 A fir tree 12 ins diam bears S7°45'E, 59.7 feet scribed C-3-820 B-4-3 BT  
 Mineral Survey number 779 calls the corner at the base of a 50 ft. high rock.

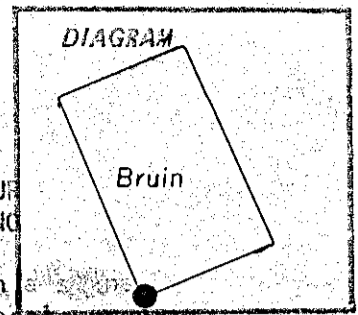

Found Southeasterly BT, blaze evident. Opened and found scribing- COR NO 4 MS 3 COR 3 MS 820.

Description of monument and accessories I established to perpetuate the original location of this corner:

At record bearing and distance of Mineral Survey number 3 from the found BT, ( this call fits the rock call as given by Mineral survey number 779) I set a 2 1/2"x30" aluminum pipe with aluminum cap marked as shown 24 inches in the ground from which:

NEW BTs

A 8 in diam red fir bears N46°E, 10.0 feet marked COR 4 B 3 BT  
 A 12 in diam red fir bears S8°E 39.5 feet marked Cor 3 C 820 BT


Raised mound of stone around monument

Set steel fence post approximately 5 feet Northeasterly with 54-2 sign and approximately 5 feet Southerly with 54-2 and 54-4 signs attached

Corner set September 27, 1982

Witnesses: Rick Robinson and Ray Crapo

See survey dated December, 1982

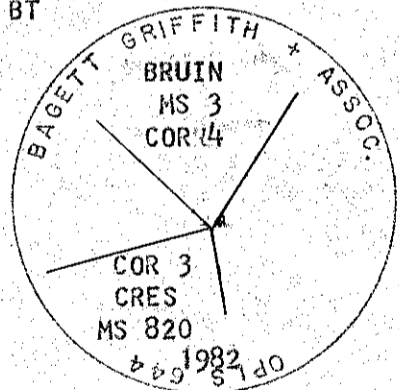

**REGISTERED  
PROFESSIONAL  
LAND SURVEYOR**

*[Handwritten signature of Duane I. Griffith]*

OREGON  
JULY 10, 1964  
**DUANE I. GRIFFITH**  
644

I hereby certify this corner was re-established as hereon described on the date written above

I used a steel tape and magnetic compass in the establishment of accessories. I used 20° East magnetic declination, and distances to the new BTs are to the center of the tree. I placed a brass washer marked OPLS 644 by the BT blaze of new BTs.

Office of..... County of.....

State of....., I hereby certify that the within instrument was filed in this office

for record on the..... day of....., 19.....

..... by .....

(COUNTY OFFICIAL)

(DEPUTY)

Form R6-7100-57 (9/71)

FILED Sept 16 1983  
 BAKER COUNTY SURVEYOR  
 SURVEY NO. 6-45-122

☆ GPO - 730-273

114 ✓