


CERTIFIED RECORD OF LAND CORNER MONUMENTATION

History of original corner establishment:

Corner originally established by William L. Hanley, Survey number 6-45-13, survey plat shows setting a 2 $\frac{1}{2}$  inch brass cap on a 1 inch pipe

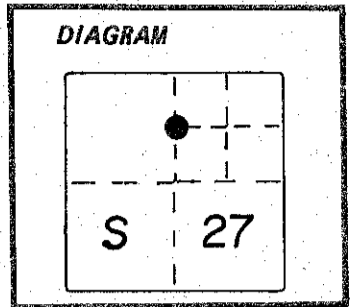

Description of corner evidence found:

Found a 2 $\frac{1}{2}$  inch brass cap on a 1 inch pipe marked as shown below in a mound of stone

Description of monument and accessories I established to perpetuate the original location of this corner:


From the above described monument:

NEW BTs

A 8 in diam white fir bears N69°E, 48.7 feet marked CN1/16 S27 BT  
 A 12 in diam white fir bears S84°W 36.7 feet marked CN1/16 S27 BT

Set steel fence post approximately 5 feet Northerly with 54-2 sign and approximately 5 feet Easterly with 54-2 and 54-9 sign attached

Corner updated October 11, 1982  
 Witnesses: Rick Robinson and Ray Crapo  
 See survey dated December, 1982

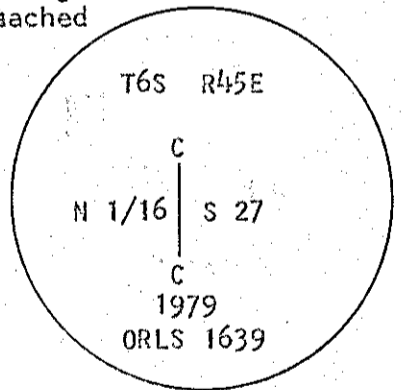

**REGISTERED  
 PROFESSIONAL  
 LAND SURVEYOR**

I hereby certify this corner was re-established as hereon described on the date written above

*Duane I. Griffith*  
 OREGON  
 JULY 10, 1964  
**DUANE I. GRIFFITH**  
 644

I used a steel tape and magnetic compass in the establishment of accessories. I used 20° East magnetic declination, and distances to the new BTs are to the center of the tree. I placed a brass washer marked OPLS 644 by the BT blaze of new BTs.

Office of..... County of.....  
 State of....., I hereby certify that the within instrument was filed in this office for record on the..... day of....., 19.....  
 ..... by .....  
 (COUNTY OFFICIAL) (DEPUTY)

FILED Sept 16 1983  
 BAKER COUNTY SURVEYOR  
 SURVEY NO. 6-45-127

119 ✓