


CERTIFIED RECORD OF LAND CORNER MONUMENTATION

History of original corner establishment:  
Corner not previously established

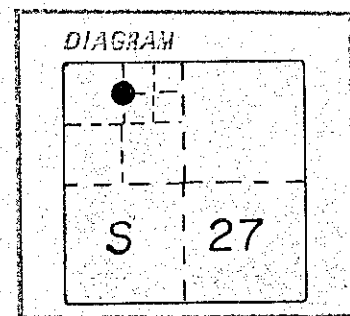

Description of corner evidence found:  
NONE

Description of monument and accessories I established to perpetuate the original location of this corner:

At corner point I set a 2 1/2" x 30" aluminum pipe with aluminum cap marked as shown 27 inches in the ground on Southerly side of ditch bank, from which:

NEW BTs

A 12 in diam white fir bears N85°E, 51.1 feet marked CNNW 1/64 S27 BT

A 37 in diam white fir bears S34°W, 13.0 feet marked CNNW 1/64 S27 BT

Raised mound of stone around monument

Set steel fence post approximately 5 feet Easterly with 54-2 sign and approximately 5 feet Northerly with 54-2 and 54-9 sign attached

Corner set October 11, 1982


Witnesses: Rick Robinson and Ray Crapo

See survey dated December, 1982

REGISTERED  
PROFESSIONAL  
LAND SURVEYOR

OREGON  
JULY 10, 1964  
DUANE I. GRIFFITH  
644

I hereby certify this corner was re-established as hereon described on the date written above

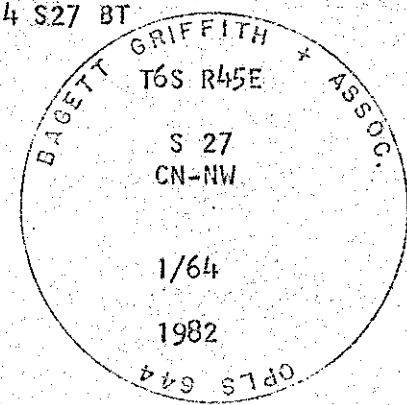

I used a steel tape and magnetic compass in the establishment of accessories. I used 20° East magnetic declination, and distances to the new BTs are to the center of the tree. I placed a brass washer marked OPLS 644 by the BT blaze of new BTs.

Office of..... County of.....  
State of..... I hereby certify that the within instrument was filed in this office for record on the..... day of....., 19.....  
..... by .....

(COUNTY OFFICIAL)

(DEPUTY)