

CERTIFIED RECORD OF LAND CORNER MONUMENTATION

History of original corner establishment:

Corner originally established by John Hagel, Mineral Survey number 370-B, under instructions dated August 2, 1899. Official record states:

Corner number 1, Senator Tabor Millsite, Set a post  $4\frac{1}{2}$  ft. long 12 ins in the ground with a mound of stones around it, marked STMS COR 1-370-B for cor no 1 of this survey.


The SE location cor. bears  $S71^{\circ}30'E$ , 169.0 feet

The  $\frac{1}{4}$  sec cor on the East boundary of Sec 21 T6S R45E W1 bears  $N70^{\circ}11'E$ , 621.2 ft.

A white fir tree 10 ins in diam bears  $S10^{\circ}15'E$  18.5 feet

A white fir tree 11 ins in diam bears  $S11^{\circ}20'E$  22.0 ft.

Both blazed and marked STMS COR 1-370-B BT

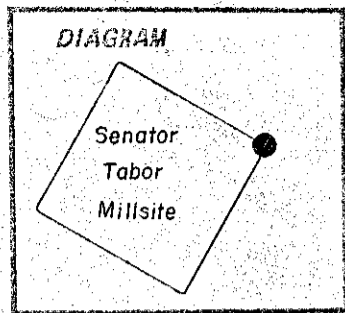

Description of corner evidence found:

Found mound of stone with bits of wood, harmonious with creek calls of mineral survey number 370-B

Description of monument and accessories I established to perpetuate the original location of this corner:

In mound of stone, I set a  $2\frac{1}{2} \times 30$ '' iron pipe with brass cap marked as shown, 26 inches in the ground, from which:

A 14 in diam alpine fir bears  $N78^{\circ}E$ , 53.3 feet marked COR 1 STMS 370B BT

A 8 in diam alpine fir bears  $N66^{\circ}W$ , 37.3 feet marked X BT


Raised mound of stone around monument

Set steel fence post approximately 5 feet Southerly with 54-4 sign attached

Corner set September 23, 1982

Witnesses: Rick Robinson

See survey dated December, 1982

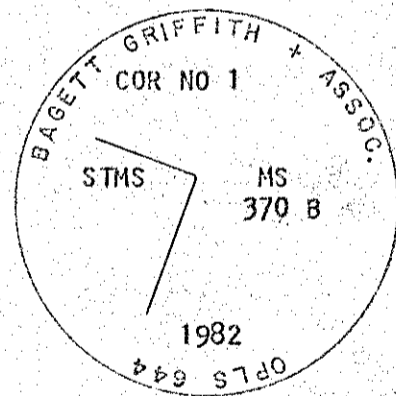

I hereby certify this corner was re-established as hereon described on the date written above

REGISTERED PROFESSIONAL LAND SURVEYOR

*Duane I. Griffith*

OREGON  
JULY 10, 1964  
DUANE I. GRIFFITH  
644

I used a steel tape and magnetic compass in the establishment of accessories. I used  $20^{\circ}$  East magnetic declination, and distances to the new BTs are to the center of the tree. I placed a brass washer marked OPLS 644 by the BT blaze of new BTs.

Office of..... County of.....

State of....., I hereby certify that the within instrument was filed in this office for record on the..... day of....., 19.....

..... by .....  
(COUNTY OFFICIAL) (DEPUTY)