TOWNSHIP 6 SOUTH, RANGE 45 EAST, OF THE WILLAMETTE MERIDIAN, OREGON

SHEET 1 OF 3

DEPENDENT RESURVEY AND SUBDIVISION OF SECTIONS

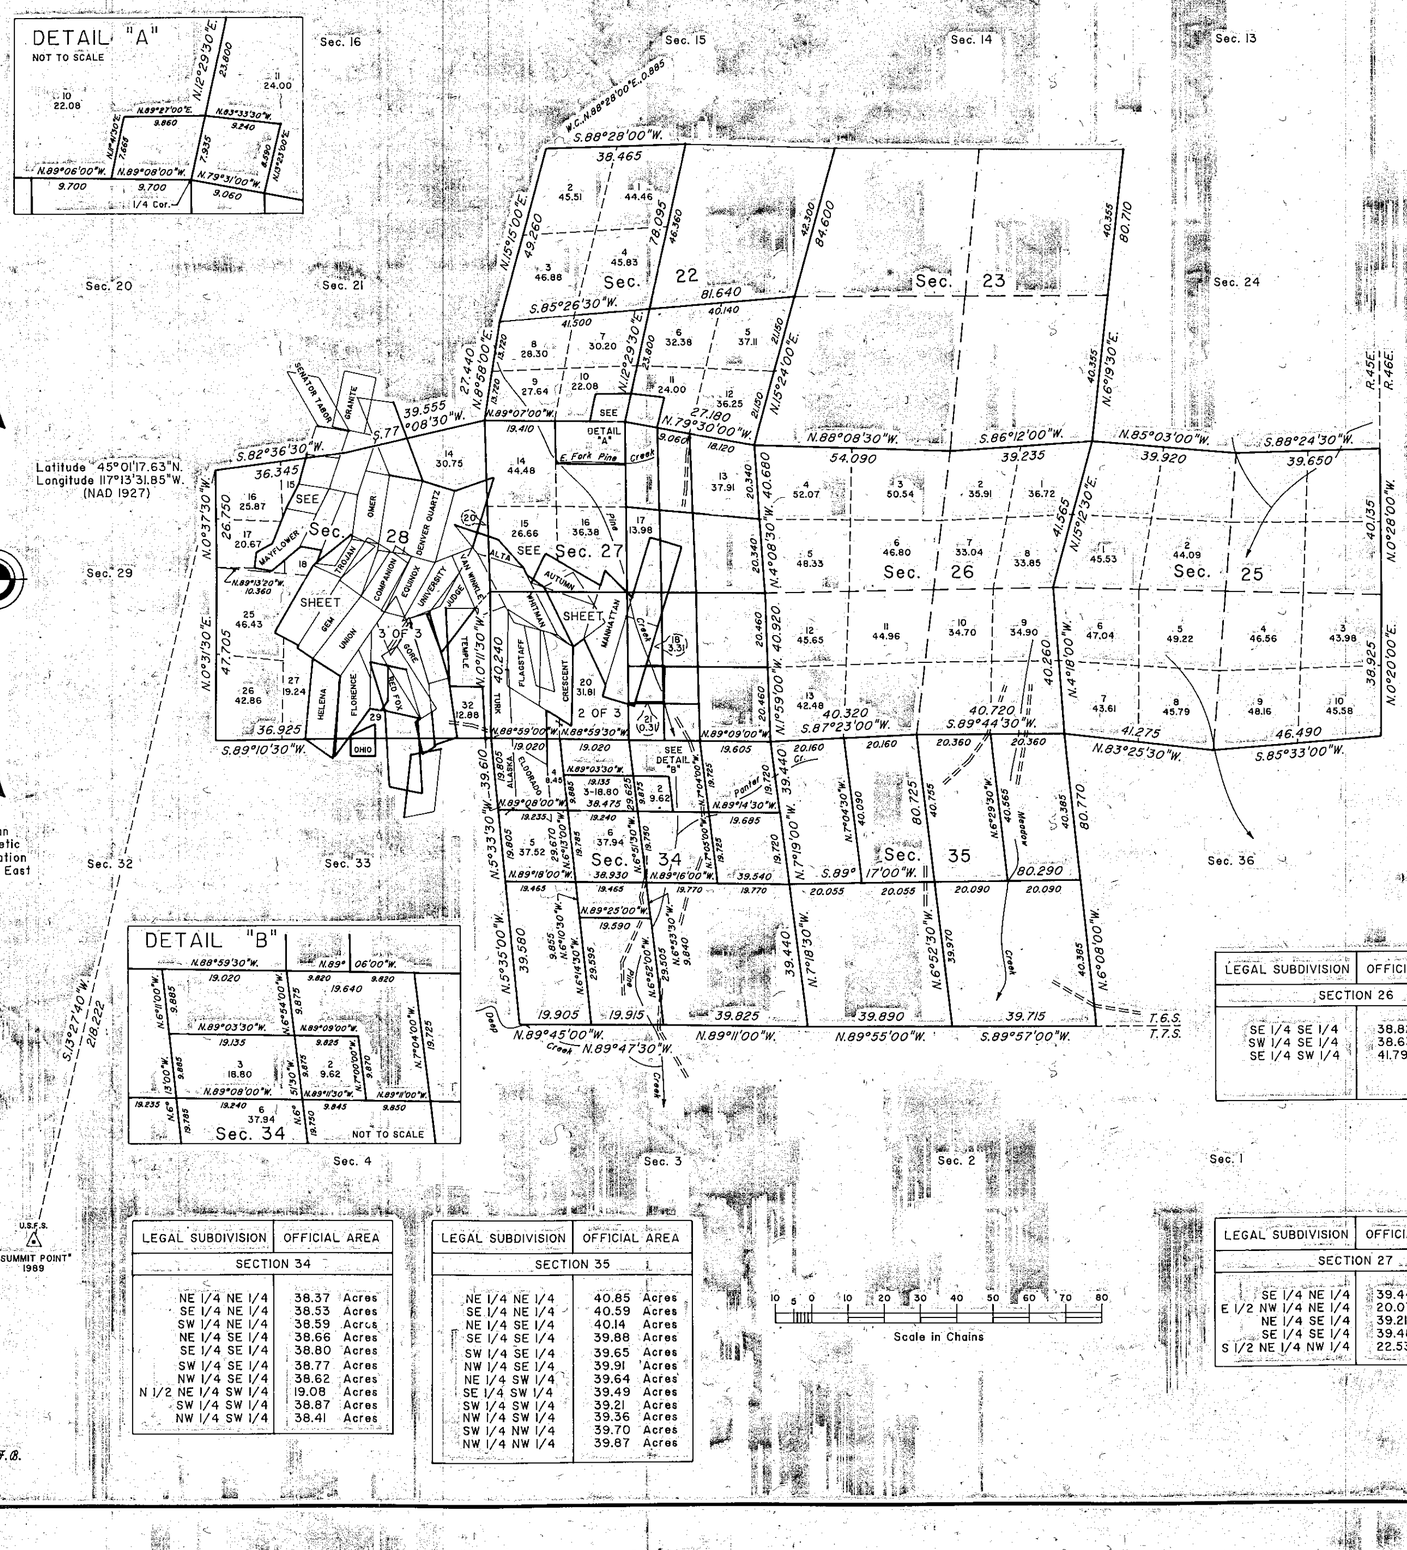

A history of surveys is contained in the field notes.

This plat represents a dependent resurvey of a portions of the south boundary, east boundary, subdivisional lines, and certain mineral survey claim boundaries, T. 6 S., R. 45 E., Willamette Meridian, Oregon, designed to restore the corners in their true original locations according to the best available evidence, and the subdivision of sections 22, 27, 34 and 35.

Except as shown hereon, the lottings and areas are as shown on the plat approved March 21, 1885.

The survey was executed by Philip G. Griffin, Cadastral Surveyor, beginning April 28, 1992, and completed August 30, 1994, pursuant to Special Instructions dated April 27, 1992, and Supplemental Special Instructions dated June 6, 1994, under Group Number 1650, Oregon.

Timber in this area consists of fir, pine and larch.

The tie to the geodetic control station is reported as mean bearing and sea level distance.

At the request of the U.S. Forest Service, the true area for each quarter-quarter section is reported for all lands under their juridiction. Where the true area is within 5% of the record area, the quarter-quarter section will retain its aliquot part designation even though the area changes. The quarter-quarter section will continue to be divided by legal subdivision. Where the record area changes by more than 5% or the quarter-quarter section is badly distorted, it has been assigned a lot number and may be further divided only by supplemental plat.

LEGAL SUBDIVISION	OFFICIAL AREA
SECTION 25	
NE 1/4 NE 1/4	40.04 Acres
SE 1/4 NE 1/4	41.74 Acres
SW 1/4 NE 1/4	40.59 Acres
NW 1/4 NE 1/4	38.90 Acres
NE 1/4 NW 1/4	40.48 Acres
NW 1/4 NW 1/4	41.91 Acres

LEGAL SUBDIVISION	OFFICIAL AREA
SECTION 26	
SE 1/4 SE 1/4	38.82 Acres
SW 1/4 SE 1/4	38.63 Acres
SE 1/4 SW 1/4	41.79 Acres

LEGAL SUBDIVISION	OFFICIAL AREA
SECTION 27	
SE 1/4 NE 1/4	39.44 Acres
E 1/2 NW 1/4 NE 1/4	20.07 Acres
NE 1/4 SE 1/4	39.21 Acres
SE 1/4 SE 1/4	39.48 Acres
S 1/2 NE 1/4 NW 1/4	22.53 Acres

LEGAL SUBDIVISION	OFFICIAL AREA
SECTION 34	
NE 1/4 NE 1/4	38.37 Acres
SE 1/4 NE 1/4	38.53 Acres
SW 1/4 NE 1/4	38.59 Acres
NE 1/4 SE 1/4	38.66 Acres
SE 1/4 SE 1/4	38.80 Acres
SW 1/4 SE 1/4	38.77 Acres
NW 1/4 SE 1/4	38.62 Acres
N 1/2 NE 1/4 SW 1/4	19.08 Acres
SW 1/4 SW 1/4	38.87 Acres
NW 1/4 SW 1/4	38.41 Acres

LEGAL SUBDIVISION	OFFICIAL AREA
SECTION 35	
NE 1/4 NE 1/4	40.85 Acres
SE 1/4 NE 1/4	40.59 Acres
NE 1/4 SE 1/4	40.14 Acres
SE 1/4 SE 1/4	39.88 Acres
SW 1/4 SE 1/4	39.65 Acres
NW 1/4 SE 1/4	39.91 Acres
NE 1/4 SW 1/4	39.64 Acres
SE 1/4 SW 1/4	39.49 Acres
SW 1/4 SW 1/4	39.21 Acres
NW 1/4 SW 1/4	39.36 Acres
SW 1/4 NW 1/4	39.70 Acres
NW 1/4 NW 1/4	39.87 Acres

UNITED STATES DEPARTMENT OF THE INTERIOR
BUREAU OF LAND MANAGEMENT

Portland, Oregon — July 7, 1997

This plat is strictly conformable to the approved field notes, and the survey, having been correctly executed in accordance with the requirements of law and the regulations of this Bureau, is hereby accepted.

For the Director

Wayne W. Gardner

Chief Cadastral Surveyor of Oregon

FILED FEB. 11, 1998
BAKER COUNTY SURVEYOR
SURVEY NO. 6-45-143