




Land Surveying & Boundary Consulting

32610 Mountain Lakes Drive
Klamath Falls, OR 97601
(541) 356-2381

**CERTIFIED RECORD OF LAND
CORNER MONUMENTATION**

45° 03' 05.771" N
117° 11' 48.159" W
NAD 1983 (98)
(BLM)

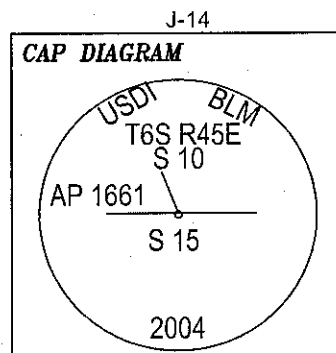

History of original corner establishment:

Richard Kaiser, BLM, 2004

Set: Point determined for an angle point on the line between sections 10 & 15 at the highest point of a ridge between Norway Creek and the East Fork of Pine Creek, designated as AP 1661 as shown in the legal boundary description for the Eagle Cap Wilderness, signed by the Regional Forester, U.S. Forest Service on June 30, 1987.

Set a stainless steel post, 28 ins. long, 2 1/2 ins. diam., 23 ins. in the ground, in a collar of stone from which:

The marks BXO, on a basalt boulder, 2 x 2 x 3 ft. high bear N 58 3/4° E 13.9 ft.

A Douglas fir, 23 ins. diam., bears S 13 3/4° W 44.5 ft. dist. marked X at breast height and BT at the base.

Deposit magnet in a white plastic case at the base of the stainless steel post.

Corner is located on the highest point of a ridge bears N 55° W and S 55° E

Description of corner evidence found:

Monument Found:

A stainless steel post, 2 1/2 ins. diam., with a 3 1/4 in. brass cap showing 7 ins. above the ground, firmly set, with a stone mound 3 ft. base to top.

Accessories Found:

A basalt boulder, 2 x 2 x 3 ft. bears N 47° E 14.1 ft. marked XBO. (Record N 58 3/4° E 13.9 ft.)

A dead, burnt fir, 25 ins. diam., bears S 45.1 ft. (record S 13 3/4° W 44.5 ft.) with X visible on the upper blaze.

Description of monument and accessories established to perpetuate corner:


Monument Set:

None

Accessories Set:

A 5/8 x 30 in. rebar with a 2 in. aluminum cap showing 5 ins. above ground bears S 1 1/2° E 9.8 ft.

An aluminum post with land survey monument sign bears S 38°E 4.7 ft.

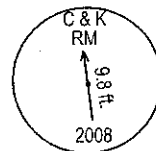

Equipment: Warren Knight staff compass with tripod, Var. 15 1/2° E,

Keson tape, clinometer, loggers tape

Crew: Richard Chesebro & Ron Grace

Date: August 5, 2008

Office of.....County Surveyor..... County of.....Baker.....

State of.....Oregon....., I hereby certify that the within was filed
in this office for record on the..... day of....., 20.....

..... by
(COUNTY OFFICIAL) (DEPUTY)

11/9/09
REGISTERED
PROFESSIONAL
LAND SURVEYOR

Richard Chesebro
OREGON
JULY 18, 1980
Richard A. Chesebro
1886
Renews: 12-31-2009

FILED Jan. 14, 2009

BAKER COUNTY SURVEYOR

SURVEY NO. 6-45-150