




Land Surveying & Boundary Consulting

32610 Mountain Lakes Drive
Klamath Falls, OR 97601
(541) 356-2381

**CERTIFIED RECORD OF LAND
CORNER MONUMENTATION**

45° 02' 14.481" N
117° 10' 57.886" W
+/- 5 Meters.
NAD 83

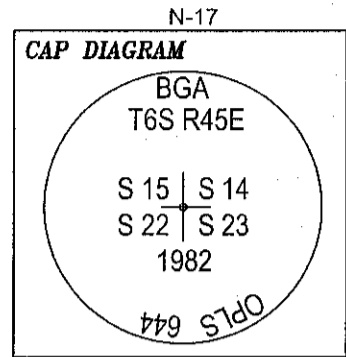

Description of corner evidence found:

Monument Found:

A 2 1/2 in. aluminum pipe with a 2 1/2 in. aluminum cap showing 6 ins. above the ground and firmly set. A rock mound 3 1/2 ft. base to top surrounds the cap. The monument falls on a 29° SE slope that is prone to snow slides.

Accessories Found:

A white fir, 33 ins. diam., bears N 69° E 79.2 ft. with a healed double blaze. (Record N 66 1/2° E 79.9 ft.) (Griffith) The tree is alive and healthy.

A white fir, 23 ins. diam., bears S 45° E 46.3 ft. with a healed double blaze. (Record S 49 1/2° E 45.5 ft.) (Griffith) The tree is alive and healthy.

A Douglas fir, 24 ins. diam., bears S 33° W 139.9 ft. with a healed double blaze. (Record S 32° W) (Griffith) This tree is alive and healthy.

A rock outcrop, 24 x 16 x 10 ins. bears N 48° W 10.8 ft. marked XBO (record 11.2 ft.) The X is very large and chiseled deep. (Griffith)

Description of monument and accessories established to perpetuate corner:

Monument Set:

None

Accessories Set:


A 5/8 x 30 in. rebar with 2 in. aluminum cap set 17 ins. in the ground bears N 55° E 4.3 ft. A rock mound 16 ins. base to top surrounds the RM.

A 5/8 x 30 in. rebar with 2 in. aluminum cap set 18 ins. in the ground bears S 58° E 6.15 ft. The rebar is driven to bedrock and is set just below a large rock in place.

A 5/8 x 30 in. rebar with 2 in. aluminum cap set 12 ins. in the ground bears S 35° W 10.7 ft. A rock mound 2 ft. x 2 ft. x 12 ins. high surrounds the RM. It is driven to bedrock.

A 5/8 x 30 in. rebar with 2 in. aluminum cap set 15 ins. in the ground bears N 63° W 3.4 ft. The rebar is driven to bedrock just below a rock in place and has a mound of stone on the downhill side.

An aluminum post with land survey monument sign bears S 5.5 ft.

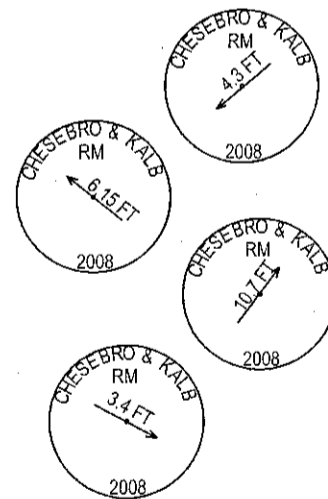

Equipment: Warren Knight staff compass with tripod, Var. 15 1/2° E, Keson tape, clinometer, loggers tape

Crew: Richard Chesebro & Ron Grace

Date: August 12, 2008

Office of.....County Surveyor..... County of.....Baker.....
State of.....Oregon....., I hereby certify that the within was filed
in this office for record on the..... day of....., 20.....
..... by
(COUNTY OFFICIAL) (DEPUTY)

119/09
REGISTERED
PROFESSIONAL
LAND SURVEYOR

Richard Chesebro
OREGON
JULY 18, 1980
Richard A. Chesebro
1886

Renews: 12-31-2009

FILED Jan. 14, 2009
BAKER COUNTY SURVEYOR
SURVEY NO. 6-45-1576