

CHESEBRO & KALB

Land Surveying &
Boundary Consulting

32610 Mountain Lakes Drive
Klamath Falls, OR 97601
(541) 356-2381

CERTIFIED RECORD OF LAND CORNER MONUMENTATION

History of original corner establishment:

W.B. Barr, GLO, 1884

Set: Marked a fir, 5 ins. diam., for 1/4 corner, 1/4 S on the N side from which:
A fir, 6 ins. diam., bears N 43° E 25 lks. (16.5 ft.) marked 1/4 S BT.
A fir, 3 ins. diam., bears S 4° E 75 lks. (49.5 ft.) marked 1/4 S BT.


Duane Griffith, PLS 644, 1982

Found: Nothing and proportioned the corner.

Set: A 2 1/2 x 30 in. iron pipe, 28 ins. in the ground, with brass cap from which:

An alpine fir, 14 ins. diam., bears N 21° E 49.0 ft. marked 1/4 S14 BT.
An alpine fir, 12 ins. diam., bears East 15.2 ft. marked 1/4 S23 BT.

Raised a mound of stone around the monument. Set a steel fence post approx. 5 ft. westerly.

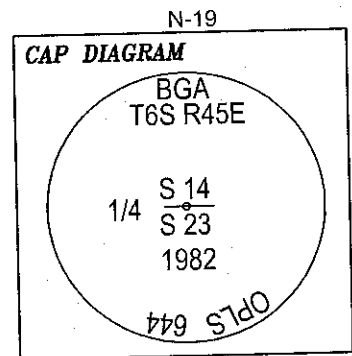

45° 02' 14.280" N
117° 10' 21.380" W
+/- 5 Meters.
NAD 83

Description of corner evidence found:

Monument Found:

A 2 1/2 in. aluminum pipe with a 2 1/2 in. aluminum cap flush with the ground and firmly set. There is a large rock adjacent to the cap and west of the cap. The cap is badly burnt and difficult to read. This corner will be surrounded by heavy brush in 2 years.

Accessories Found:

A dead subalpine fir, 29 ins. diam., bears N 21° E 49.0 ft. with a partially healed double blaze with some scribing visible on the upper blaze. The tree has a double top about 6 ft. up. (Griffith)
A subalpine fir, 25 ins. diam., bears East 15.2 ft. with visible scribing on a double blaze. The tree is alive and looks healthy but has ants near the base. The tree is also leaning heavily towards the cap and eventually will fall on the cap.

Description of monument and accessories established to perpetuate corner:

Monument Set:

None

Accessories Set:

A 5/8 x 30 in. rebar with 2 in. aluminum cap set 26 ins. in the ground bears N 40° E 4.2 ft. The rebar is set on the N side of a large rock.

A 5/8 x 30 in. rebar with 2 in. aluminum cap set 26 ins. in the ground bears S 33 1/2° E 3.9 ft. The rebar is east of and adjacent to a large rock.

A 5/8 x 30 in. rebar with 2 in. aluminum cap set 27 ins. in the ground bears S 52° W 5.4 ft.


A 5/8 x 30 in. rebar with 2 in. aluminum cap set 27 ins. in the ground bears N 38° W 4.95 ft.

An aluminum post with land survey monument sign bears N 77° W 5.0 ft.

Equipment: Warren Knight staff compass with tripod, Var. 15 1/2° E,
Keson tape, clinometer, loggers tape

Crew: Richard Chesebro & Ron Grace

Date: August 12, 2008

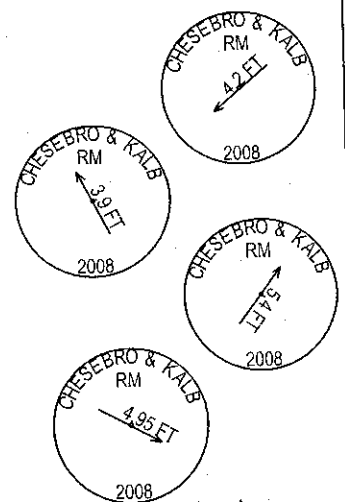

**REGISTERED
PROFESSIONAL
LAND SURVEYOR**

Richard Chesebro
OREGON
JULY 18, 1980
Richard A. Chesebro
1886

Renews: 12-31-2009

Office of.....County...Surveyor..... County of.....Baker.....

State of.....Oregon....., I hereby certify that the within was filed

in this office for record on the..... day of....., 20.....

..... by

(COUNTY OFFICIAL)

(DEPUTY)

FILED Jan. 14, 2009

BAKER COUNTY SURVEYOR

SURVEY NO. 6-45-157