




Land Surveying &
Boundary Consulting

32610 Mountain Lakes Drive
Klamath Falls, OR 97601
(541) 356-2381

**CERTIFIED RECORD OF LAND
CORNER MONUMENTATION**

45° 01' 48.013" N
117° 09' 48.780" W
+/-5 Meters.
NAD 83

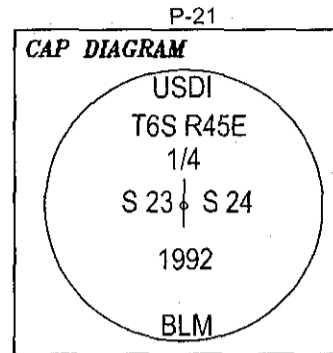

History of original corner establishment:

W.B. Barr, GLO, 1884

Set: A granite rock in place, 24 x 18 x 14 ins. in ground marked with a cross (X) on the top and 1/4 on the W side, from which:

A fir, 12 ins. diam., bears S 40° W 15 lks. (9.9 ft.) marked 1/4 S BT.

A spruce, 8 ins. diam., bears S 70° W 27 lks. (17.8 ft.) marked 1/4 S BT.

Duane Griffith, PLS 644, 1982

Found: Nothing

Set: At proportionate distance set a 2 1/2 x 30 in. iron pipe, 18 ins. in the ground, with brass cap from which:

A twin top tamarack, 20 ins. diam., bears N 2° E 44.3 ft. marked 1/4 S24 BT.

A white fir, 10 ins. diam., bears N 64° W 43.7 ft. marked 1/4 S23 BT.

Raised a mound of stone around monument. Set steel fence post approx. 5 ft. southerly.

Philip Griffin, BLM 1994

Found: Nothing.

Set: At proportionate distance, set a stainless steel post, 28 ins. long 2 1/2 ins. diam., 22 ins. in the ground, in a collar of stone with brass cap from which:

A lodgepole pine, 22 ins. diam., bears N 81° E 112 lks (73.9 ft.) marked 1/4 S24 BT.

A fir, 10 ins. diam., bears S 75° W 29 lks (19.1 ft.) marked 1/4 S23 BT.

From this point, a point established as the 1/4 section corner of secs. 23 & 24 by Duane Griffith, Registered Land Surveyor No. 644, in 1982, filed with the Baker County Surveyor under survey number 6-45-31, bears S 89° 47' 10" W 2.482 chs. (163.81 ft.), monumented with an iron post, 2 1/2 ins. diam., firmly set, projecting 6 ins. above ground and in a mound of stone 3 ft. base to top, with brass cap marked Bagett Griffith & Assoc T6S R45E 1/4 S23 S24 1982 OPLS 644. This point was established using erroneous control and is not utilized in this survey, from which bearing trees by Griffith:

A broken larch, 24 ins. diam., bears N 1 1/2 ° E 67 lks. (44.2 ft.) with healed double blaze.

A fir, 12 ins. diam., bears N 62° W 71 1/2 lks. (47.2 ft.) with fragmentary scribe marks on partially healed double blaze.

119109
REGISTERED
PROFESSIONAL
LAND SURVEYOR

Richard Chesebro
OREGON
JULY 18, 1980
Richard A. Chesebro
1886
Renews: 12-31-2009

Office of.....County Surveyor..... County of.....Baker.....
State of.....Oregon....., I hereby certify that the within was filed
in this office for record on the..... day of....., 20.....
..... by
(COUNTY OFFICIAL) (DEPUTY)

FILED JAN. 14, 2009
BAKER COUNTY SURVEYOR
SURVEY NO. 6-45-161