




Land Surveying & Boundary Consulting

32610 Mountain Lakes Drive
Klamath Falls, OR 97601
(541) 356-2381

CERTIFIED RECORD OF LAND CORNER MONUMENTATION

45° 01' 48.013" N
117° 09' 48.780" W
+/- 5 Meters.
NAD 83

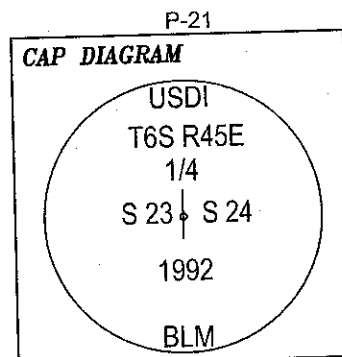

Description of corner evidence found:

Monument Found:

A 3 1/4 in brass cap, flush with the ground and with a collar of stone.

Accessories Found:

No evidence of the NE BT was found. (Griffin)
A white fir, 12 ins. diam., bears S 70° W 19.1 ft. with a healed single blaze. This tree is healthy.
Distance is measured to the face. (Record S 75° W)(Griffin)

Description of monument and accessories established to perpetuate corner:

Monument Set:

None

Accessories Set:

- A 5/8 x 30 in. rebar with 2 in. aluminum cap set 30 ins. in the ground bears N 33° E 6.45 ft.
- A boulder, 5 x 3 x 4 ft. high, bears S 66° E 6.9 ft. marked XBO.
- A 5/8 x 30 in. rebar with 2 in. aluminum cap set 26 ins. in the ground bears S 42° E 6.1 ft.
- A 5/8 x 30 in. rebar with 2 in. aluminum cap set 30 ins. in the ground bears S 28° W 4.9 ft. The rebar is just S of a large boulder.
- A 5/8 x 30 in. rebar with 2 in. aluminum cap set 30 ins. in the ground bears N 52° W 5.2 ft.
- An aluminum post with land survey monument sign bears S 32° E 6.7 ft.

Equipment: Warren Knight staff compass with tripod, Var. 15 1/2° E,
Keson tape, clinometer, loggers tape

Crew: Richard Chesebro & Ron Grace

Date: August 21, 2008



Office of.....County Surveyor..... County of.....Baker.....
 State of.....Oregon....., I hereby certify that the within was filed
 in this office for record on the..... day of....., 20.....
 by
 (COUNTY OFFICIAL) (DEPUTY)

1/9/09
REGISTERED PROFESSIONAL LAND SURVEYOR

Richard Chesebro
OREGON
JULY 18, 1980
Richard A. Chesebro
1886
Renews: 12-31-2009

FILED JAN. 14, 2009
BAKER COUNTY SURVEYOR
SURVEY NO. 6-45-161