




Land Surveying & Boundary Consulting

32610 Mountain Lakes Drive  
Klamath Falls, OR 97601  
(541) 356-2381

**CERTIFIED RECORD OF LAND CORNER MONUMENTATION**

45° 01' 21.324" N  
117° 11' 18.529" W  
+/- 5 Meters.  
NAD 83

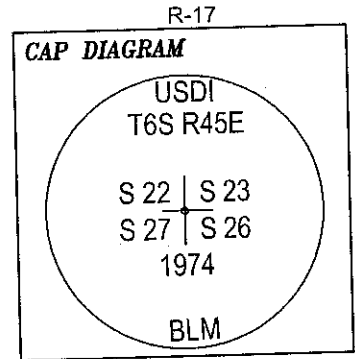

Description of corner evidence found:

Monument Found:

An iron pipe, 2 1/2 ins. diam., with a 3 1/4 in. brass cap, firmly set, showing 6 ins. above the ground. The original stone is firmly set just N of the cap with 2 notches visible on the E side. No post and sign was found. The corner falls on a 38° N slope.

Accessories Found:

A subalpine fir, 15 ins. diam., bears N 67° E 27.7 ft. with a healed single blaze. This tree is alive and healthy. (Record N 64 1/2° E) (Fischer)

A dead western larch, 7 ins. diam., bears S 33 1/2° E 56.2 ft. with a healed single blaze. (Record S 37° E 56.8 ft.) (Fischer)

A white fir, 36 ins. diam., bears S 53° W 32.2 ft. with a healed single blaze. This tree has a dead top. (Record S 51 1/2° W 31.0 ft.) (Original)

A Douglas fir, 19 ins. diam., bears N 85° W 40.7 ft. with a healed single blaze. This tree is alive and healthy. (Record N 89° W 38.9 ft.) (Fischer)

Description of monument and accessories established to perpetuate corner:

Monument Set:

None

Accessories Set:


A 5/8 x 30 in. rebar with 2 in. aluminum cap set 27 ins. in the ground bears N 64° E 5.2 ft.

A 5/8 x 30 in. rebar with 2 in. aluminum cap set 29 ins. in the ground bears S 45° E 6.6 ft.

A 5/8 x 30 in. rebar with 2 in. aluminum cap set 24 ins. in the ground bears S 31° W 8.2 ft.

A 5/8 x 30 in. rebar with 2 in. aluminum cap set 29 ins. in the ground bears N 50° W 4.05 ft.

An aluminum post with land survey monument sign bears S 62° E 7.4 ft.

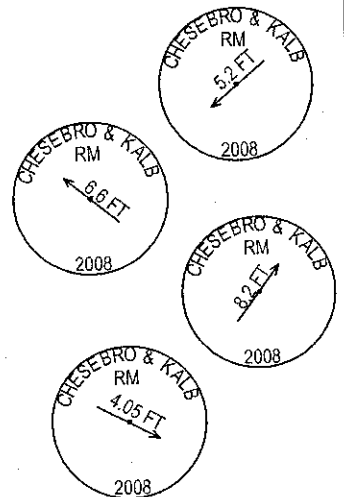

Equipment: Warren Knight staff compass with tripod, Var. 15 1/2° E,  
Keson tape, clinometer, loggers tape  
Crew: Richard Chesebro & Ron Grace  
Date: August 20, 2008

Office of.....County.....Surveyor..... County of.....Baker.....  
State of.....Oregon....., I hereby certify that the within was filed  
in this office for record on the..... day of....., 20.....  
..... by ..... (DEPUTY)  
(COUNTY OFFICIAL)

119/09  
REGISTERED PROFESSIONAL LAND SURVEYOR

Richard Chesebro  
OREGON  
JULY 18, 1980  
Richard A. Chesebro  
1886  
Renews: 12-31-2009

FILED JAN. 14 2009  
BAKER COUNTY SURVEYOR  
SURVEY NO. 6-45-163