




Land Surveying & Boundary Consulting

32610 Mountain Lakes Drive
Klamath Falls, OR 97601
(541) 356-2381

CERTIFIED RECORD OF LAND CORNER MONUMENTATION

45° 01' 21.873" N
117° 09' 52.873" W
+/- 5 Meters.
NAD 83

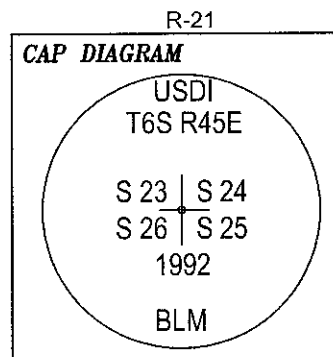

History of original corner establishment:

W.B. Barr, GLO, 1884

Set: A post, 4 ft. long, 4 ins. diam., 24 ins. in the ground marked T6S S24 on the NE, R45E S25 on the SE faces, S26 on the SW and S23 on the NW faces with 2 notches on the S and 1 notch on the E edges from which:

- A spruce, 4 ins. diam., bears N 27° E 10 lks. (6.6 ft.) marked T6S R45E S24 BT.
- A fir, 6 ins. diam., bears S 45° E 14 lks. (9.2 ft.) marked T6S R45E S25 BT.
- A spruce, 5 ins. diam., bears S 15° W 19 lks. (12.5 ft.) marked T6S R45E S26 BT
- A fir, 5 ins. diam., bears N 33° W 13 lks. (8.6 ft.) marked T6S R45E S23 BT.

Duane Griffith, PLS 644, 1982

Found: Nothing.

Set: At proportionate distance, set a 2 1/2 x 30 in. iron pipe, 28 ins. in the ground, with brass cap from which:

- A tamarack, 11 ins. diam., bears N 7° E 70.9 ft. marked T6S R45E S24 BT.
 - A white fir, 16 ins. diam., bears S 50° E 88.1 ft. marked T6S R45E S25 BT.
 - A white fir, 13 ins. diam., bears S 30° W 66.2 ft. marked T6S R45E S26 BT.
 - A tamarack, 10 ins. diam., bears N 7° W 60.5 ft. marked T6S R45E S23 BT.
- Raised a mound of stone around the monument. Set steel fence post approx. 5 ft. southerly.

Philip Griffin, BLM, 1994

Found: Nothing.

Set: At proportionate distance, set a stainless steel post, 28 ins. long, 2 1/2 ins. diam., 22 ins. in the ground, in a collar of stone with brass cap from which:

- A lodgepole pine, 15 ins. diam., bears N 34° E 101 lks (66.7 ft.) marked T6S R45E S24 BT.
- A larch, 18 ins. diam., bears S 22° E 99 lks (65.3 ft.) marked T6S R45E S25 BT.
- A spruce, 12 ins. diam., bears S 41° W 157 lks (103.6 ft.) marked T6S R45E S26 BT.
- A rock outcrop, 3 1/2 x 2 x 3 1/2 ft. above ground bears N 48° W 13 lks (8.6 ft.) to the marks BXO on the E face near the top.

The corner is located in a rocky area at the center of a clearing.

From this point, a point established as the corner of sections 23 24, 25, 26, by Duane Griffith, Registered Land Surveyor No. 644, in 1982, filed with the Baker County Surveyor under survey number 6-45-31, bears N 89° 59' 30" W 4.972 chs. (328.15 ft.), monumented with an iron post, 2 1/2 ins. diam., firmly set, projecting 2 ins. above ground and in a collar of stone, with brass cap marked Bagett Griffith & Assoc T6S R45E S23 S24 S25 S26 1982 OPLS 644. This point was established using erroneous control and is not utilized in this survey, from which bearing trees by Griffith:

- A larch, 12 ins. diam., bears N 31 1/2 ° E 107 lks (70.6 ft.) with fragmentary scribe marks on partially healed blaze.
- A fir, 18 ins. diam., bears S 50° E 133 lks (87.8 ft.) with scribe marks T6S R45E S25 BT on an open double blaze.
- A fir, 12 ins. diam., bears S 29° W 100 lks (66.0 ft.) with scribe marks T6S R45E S26 BT on an open double blaze.
- A larch, 10 ins. diam., bears N 9 1/2 ° W 91 lks (60.1 ft.) with healed double blaze.

Office of.....County...Surveyor..... County of.....Baker.....
State of.....Oregon....., I hereby certify that the within was filed
in this office for record on the..... day of....., 20.....
..... by
(COUNTY OFFICIAL) (DEPUTY)

1/9/09
REGISTERED PROFESSIONAL LAND SURVEYOR

Richard Chesebro
OREGON
JULY 18, 1980
Richard A. Chesebro
1886
Renews: 12-31-2009

FILED JAN. 14, 2009
BAKER COUNTY SURVEYOR
SURVEY NO. 6-45-165