




Land Surveying & Boundary Consulting

32610 Mountain Lakes Drive
Klamath Falls, OR 97601
(541) 356-2381

CERTIFIED RECORD OF LAND CORNER MONUMENTATION

45° 00' 28.829" N
117° 10' 56.018" W
+/- 5 Meters.
NAD 83

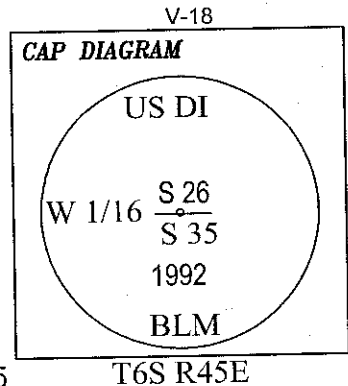

History of original corner establishment:

Duane Griffith, PLS 644, 1982

Set: A 2 1/2 x 30 in. aluminum pipe, 28 ins. in the ground, with an aluminum cap from which:

A white fir, 20 ins. diam., bears N 45° E 16.5 ft. marked W 1/16 S26 BT.

A red fir, 12 ins. diam., bears S 84° E 22.1 ft. marked W 1/16 S35 BT.

Raised a mound of stone around the monument. Set steel fence post approx 5 ft. easterly and 5 ft. southerly.

Philip Griffin, BLM, 1994

Set: A stainless steel post, 28 ins. long, 2 1/2 ins. diam., 22 ins. in the ground, and in a collar of stone, with brass cap from which:

A fir, 28 ins. diam., bears N 41° E 28 lks. (18.5 ft.) marked W 1/16 S26 BT.

A fir, 25 ins. diam., bears S 60° E 11 lks. (7.3 ft.) marked W 1/16 S35 BT.

Deposit a white "Deep-1" magnetic marker at base of stainless steel post and set a steel fence post alongside.

From this point, a point established as the W 1/16 section corner of secs. 26 & 35 by Duane Griffith, Registered Land Surveyor No. 644, in 1982, filed with the Baker County Surveyor under survey number 6-45-31, bears S 55° 17'00" 0.722 chs. (47.65 ft.), monumented with an aluminum post, 2 1/2 ins. diam., firmly set, projecting 2 ins. above ground and in a collar of stone with an aluminum cap marked Bagett Griffith & Assoc T6S R45E W 1/16 S26 S35 1982 OPLS 644. This point was established using erroneous control and is not utilized in this survey, from which bearing trees by Griffin:

A fir, 18 ins. diam., bears N 49° E 25 lks. (16.5 ft.) with fragmentary scribe marks on partially healed double blaze.

A fir, 14 ins. diam., bears S 84° E 33lks. (21.8 ft.) with healed double blaze.

Description of corner evidence found:

Chesebro & Kalb, PLS 1886, 2008

Monument Found: A stainless steel post 2 1/2 ins. diam with a 3 1/4 in. brass cap showing 5 ins. above the ground and leaning approximately 5° downhill. I straighten the cap to vertical. The monument falls in a game trail and is approximately 100 ft. N of an old road.

Accessories Found:

A white fir, 25 ins. diam., bears N 41° E 17.4 ft. marked W 1/16 S26 BT on an open single blaze. This tree is healthy. (Record 18.5 ft.) (Griffin)

A Douglas fir, 23 ins. diam., bears S 56° E 7.3 ft. with a healed single blaze. This tree is healthy. (Record S 60° E)(Griffin)

Description of monument and accessories established to perpetuate corner:

Monument Set:

None.

Accessories Set:

A 5/8 x 30 in. rebar with 2 in. aluminum cap set 30 ins. in the ground bears N 16° E 7.1 ft.

A 5/8 x 30 in. rebar with 2 in. aluminum cap set 26 ins. in the ground bears N 85° E 8.7 ft.


An aluminum post with land survey monument sign bears N 60° W 3.2 ft.

Equipment: Warren Knight staff compass with tripod, Var. 15 1/2° E,

Keson tape, clinometer, loggers tape

Crew: Richard Chesebro & Ron Grace

Date: August 22, 2008

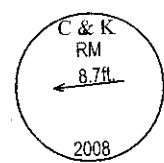

11/9/09
REGISTERED PROFESSIONAL LAND SURVEYOR

Richard Chesebro
OREGON
JULY 18, 1980
Richard A. Chesebro
1886
Renews: 12-31-2009

Office of.....County Surveyor..... County of.....Baker.....

State of.....Oregon....., I hereby certify that the within was filed

in this office for record on the..... day of....., 20.....

..... by (DEPUTY)
(COUNTY OFFICIAL)

FILED JAN 14 2009

BAKER COUNTY SURVEYOR

SURVEY NO. 6-45-1166