




Land Surveying & Boundary Consulting

32610 Mountain Lakes Drive
Klamath Falls, OR 97601
(541) 356-2381

**CERTIFIED RECORD OF LAND
CORNER MONUMENTATION**

45° 00' 29.368" N
117° 10' 18.811" W
+/- 5 Meters.
NAD 83

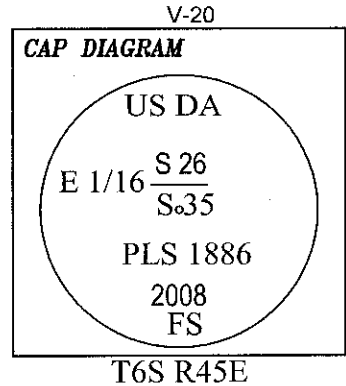

History of original corner establishment:

Duane Griffith, PLS 644, 1982

Set: a 2 1/2 x 30 in. aluminum pipe, 28 ins. in the ground, with an aluminum cap from which:

- A pine, 10 ins. diam., bears S 31° W 24.3 ft. marked E 1/16 S35 BT.
- A white fir, 13 ins. diam., bears N 41° W 23.5 ft. marked E 1/16 S26 BT.
- Set steel fence post approx. 5 ft. southerly.

Philip Griffin, BLM, 1992

Set: A stainless steel post, 28 ins. long, 2 1/2 ins. diam., 22 ins. in the ground and in a collar of stone with brass cap from which:

- A lodgepole pine, 12 ins. diam., bears S 67 3/4° E 155 lks. (102.3 ft.) marked E 1/16 S35 BT.
- A lodgepole pine, 12 ins. diam., bears N 75° W 148 lks. (97.7 ft.) marked E 1/16 S26 BT.
- Deposit a white "Deep-1" magnetic marker at base of stainless steel post and set steel fence post alongside.

From this point, a point established as the E 1/16 section corner of secs. 26 & 35 by Duane Griffith, Registered Land Surveyor No. 644, in 1982, filed with the Baker County Surveyor under survey number 6-45-31, bears S 78° 39' 30" W 2.033 chs. (134.17 ft.), monumented with an aluminum post, 2 1/2 ins. diam., firmly set, projecting 3 ins. above ground and with aluminum cap marked Bagett Griffith & Assoc T6S R45E E 1/16 S26 S35 1982 OPLS 644. This point was established using erroneous control and is not utilized in this survey, from which bearing trees by Griffith:

- A ponderosa pine, 10 ins. diam., bears S 29° W 37 lks. (24.4 ft.) with fragmentary scribe marks on partially healed blaze.
- A fir, 15 ins. diam., bears N 40° W 36 lks. (23.8 ft.) with fragmentary scribe marks on partially healed blaze.

Description of corner evidence found:

Monument Found: None, the monument had been pushed out of the ground during cat work on a fire line and subsequently delivered to the USFS in Enterprise. We did find the "Deep-1" magnet approximately 22 ins. down lying on its side, but in its original position. This was determined by subsequent measurement to the bearing trees.

Accessories Found:

- A dead Lodgepole Pine, 12 ins. diam., bears S 67 3/4° E 102.3 ft. marked E 1/16 S 35 BT on a single blaze. (Griffin)
- A Lodgepole Pine, 14 ins. diam., bears N 75° W 97.7 ft. with fragmentary scribing visible on a pitched over single blaze. This tree is alive and healthy. (Griffin)

Description of monument and accessories established to perpetuate corner:

Monument Set: A 2 1/2 in. aluminum pipe, with a 3 1/4 in. aluminum cap, vertically over the found "Deep-1" magnet. The monument is set 20 ins. in the ground. A rock mound 20 ins. base and 8 ins. high surrounds the monument. I bury the BLM monument on the N side of the cap and approximately 12 ins. deep.

Accessories Set:

- A 5/8 x 30 in. rebar with 2 in. aluminum cap set 29 ins. in the ground bears N 8° W 73.1 ft.
- A 5/8 x 30 in. rebar with 2 in. aluminum cap set 29 ins. in the ground bears N 76° W 50.0 ft.

Note: Both RMs were placed on National Forest Lands. No new signs, paint or aluminum post were used in order to reduce the visual impact on adjoining private property.

Equipment: Warren Knight staff compass with tripod, Var. 15 1/2° E,

Keson tape, clinometer, loggers tape

Crew: Richard Chesebro & Ron Grace

Date: August 22, 2008

Office of.....County Surveyor..... County of.....Baker.....

State of.....Oregon....., I hereby certify that the within was filed in this office for record on the..... day of....., 20.....

..... by (COUNTY OFFICIAL) (DEPUTY)



1/9/09
REGISTERED PROFESSIONAL LAND SURVEYOR

Richard Chesebro
OREGON
JULY 18, 1980
Richard A. Chesebro
1886
Renews: 12-31-2009

FILED JAN 14 2009
BAKER COUNTY SURVEYOR
SURVEY NO. 6-45-168