


CERTIFIED RECORD OF LAND CORNER MONUMENTATION

History of original corner establishment:

Corner originally established by W.B. Barr under GLO contract No 503, dated May 23, 1884. Surveyor General record states: Set volcanic rock 16x11x10, 11 inches in ground for corner to sec. 19,24,25+30 marked with 4 notches on the N. and 2 notches on the S. edges from which A quaking aspen 8 in diam bears N27°E 120 lks dist marked T6S R46E S19 BT. A quaking aspen 9 in diam bears S25°W 4 lks dist marked T6S R45E S25 BT. A fir 5 in diam bears N69°W 61 lks dist marked T6S R45E S24 BT. No other trees within limits. Raised mound of rock alongside. Corner remonumented by Lester E. Fischer for the BLM under U.S. Survey Group No. 350 dated August 22, 1974. Official record states in part: Found marked corner stone, firmly set and remains of the original BTs. A fir 14 in diam bears N69°W, 61 lks dist with scribes visible. At the corner point set an iron post with brass cap from which new bearing trees: A lodgepole pine 12 in diam bears S38°E 196 lks dist marked T6S R46 S30 BT. A lodgepole pine 20 in diam bears S14°W 180 lks dist marked T6S R45E S25 BT. Buried stone alongside iron post.

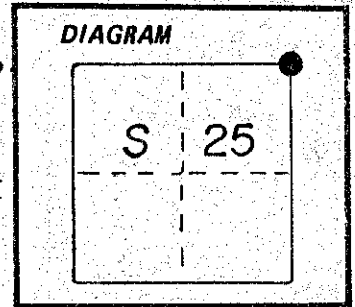

Description of corner evidence found:

- Found standard BLM brass cap marked as shown below, in mound of stone
- Found Southwest BLM BT, live and vigorous, record distance and bearing
- Found Northwest BLM BT, live and vigorous, record distance and bearing (original tree)
- Found Southeast BLM BT, dead, record distance and bearing

Description of monument and accessories I established to perpetuate the original location of this corner:

From the above described monument:

NEW BT

A 21 in diam red fir bears S37°E, 122.8 feet marked T6S R46E S30 BT
 No tree available in section 19, I therefore set a steel fence post North, 3.8 feet from the monument with a 54-4 sign attached as a bearing object, in mound of stone.

Raised mound of stone around existing monument


Corner updated August 12, 1982

Witnesses: Greg Blackman and Rick Robinson

See survey dated December, 1982

September 12, 1983, chiseled X B0 in boulder 30"x24"x18" high North 15°East, 5.5 feet from corner monument

I hereby certify this corner was re-established as hereon described on the data written above

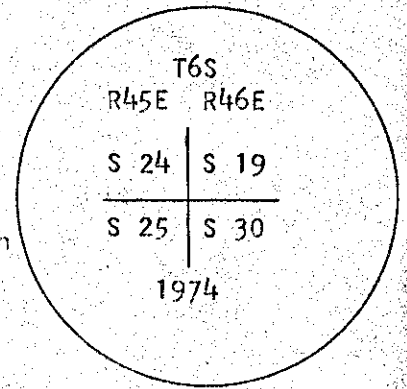

**REGISTERED
PROFESSIONAL
LAND SURVEYOR**

[Signature]

OREGON
JULY 10, 1964
DUANE I. GRIFFITH
644

I used a steel tape and magnetic compass to establish these accessories. I used 20°East magnetic declination and the distance to the new BT is to the center of the tree. I placed a brass washer marked OPLS 644 by the BT blaze on the new BT.

Office of..... County of.....
 State of..... I hereby certify that the within instrument was filed in this office
 for record on the..... day of....., 19.....
 by
 (COUNTY OFFICIAL) (DEPUTY)