


Index File No. T-1 CORNER RECORD (SEARCH) Tract or Survey No. _____ Cor. W 1/4 COR
6 S R. 1/8 E R.D. PINE County Baker No. SEC 30
 Merid. Willamette N.F. Wallowa-Whitman State Oregon

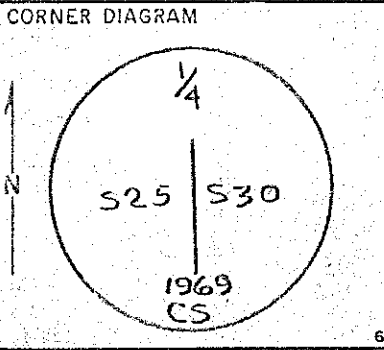

DESCRIBE CORNER MONUMENT FOUND

None. This area had been traversed by crawler type vehicle and any monument or B.T.'s. were destroyed.

DESCRIBE BEARING TREES OR OTHER OFFICIAL ACCESSORIES FOUND

None

PHOTO IDENTIFICATION DATA

Photo No. _____
 Filed At. _____
 Object Ident. _____
 Ident. By _____
Signature

DESCRIBE CORNER LOCATION RELATIVE TO NEAR-BY FEATURES, ALSO HOW TO REACH CORNER

PLANE COORDINATE POSITION DATA

State _____ Zone _____
 X _____
 Y _____
 Estab. By _____
Agency

Signature _____ Title _____ Division _____ Headquarters _____ Date _____ 7100-52
 REV. 65 5

CORNER RECORD (PERPETUATION)

MONUMENT: DESCRIBE NEW MONUMENT SET, OR WORK DONE TO PRESERVE EXISTING MONUMENT

Set 1-inch galvanized pipe with 2-inch aluminum cap marked as shown. Set by single proportionate distance between N.W. and S.W. sec. 30 corners.

ACCESSORIES DESCRIBE NEW BT'S WITNESS OBJECTS ETC. ESTABLISHED, OR WORK DONE TO PRESERVE EXISTING EVIDENCE

Mound of stone around monument.

Work Done By J. D. Hanley Title Engineer Date 7-69 State Registration No. Oregon P.E. 2808
 or Agency _____
 Certified Cor. Record Prepared? Yes No Filed At. _____ Date _____

REMARKS

SURVEY NO. 6-48-3

