VICINITY MAP
1"=1320'

LEGEND

- ○ Found monument as noted.
- ● Set ½"×24" rebar except ⅝"×30" rebar at exterior corners.
- (120) Original plat distance.

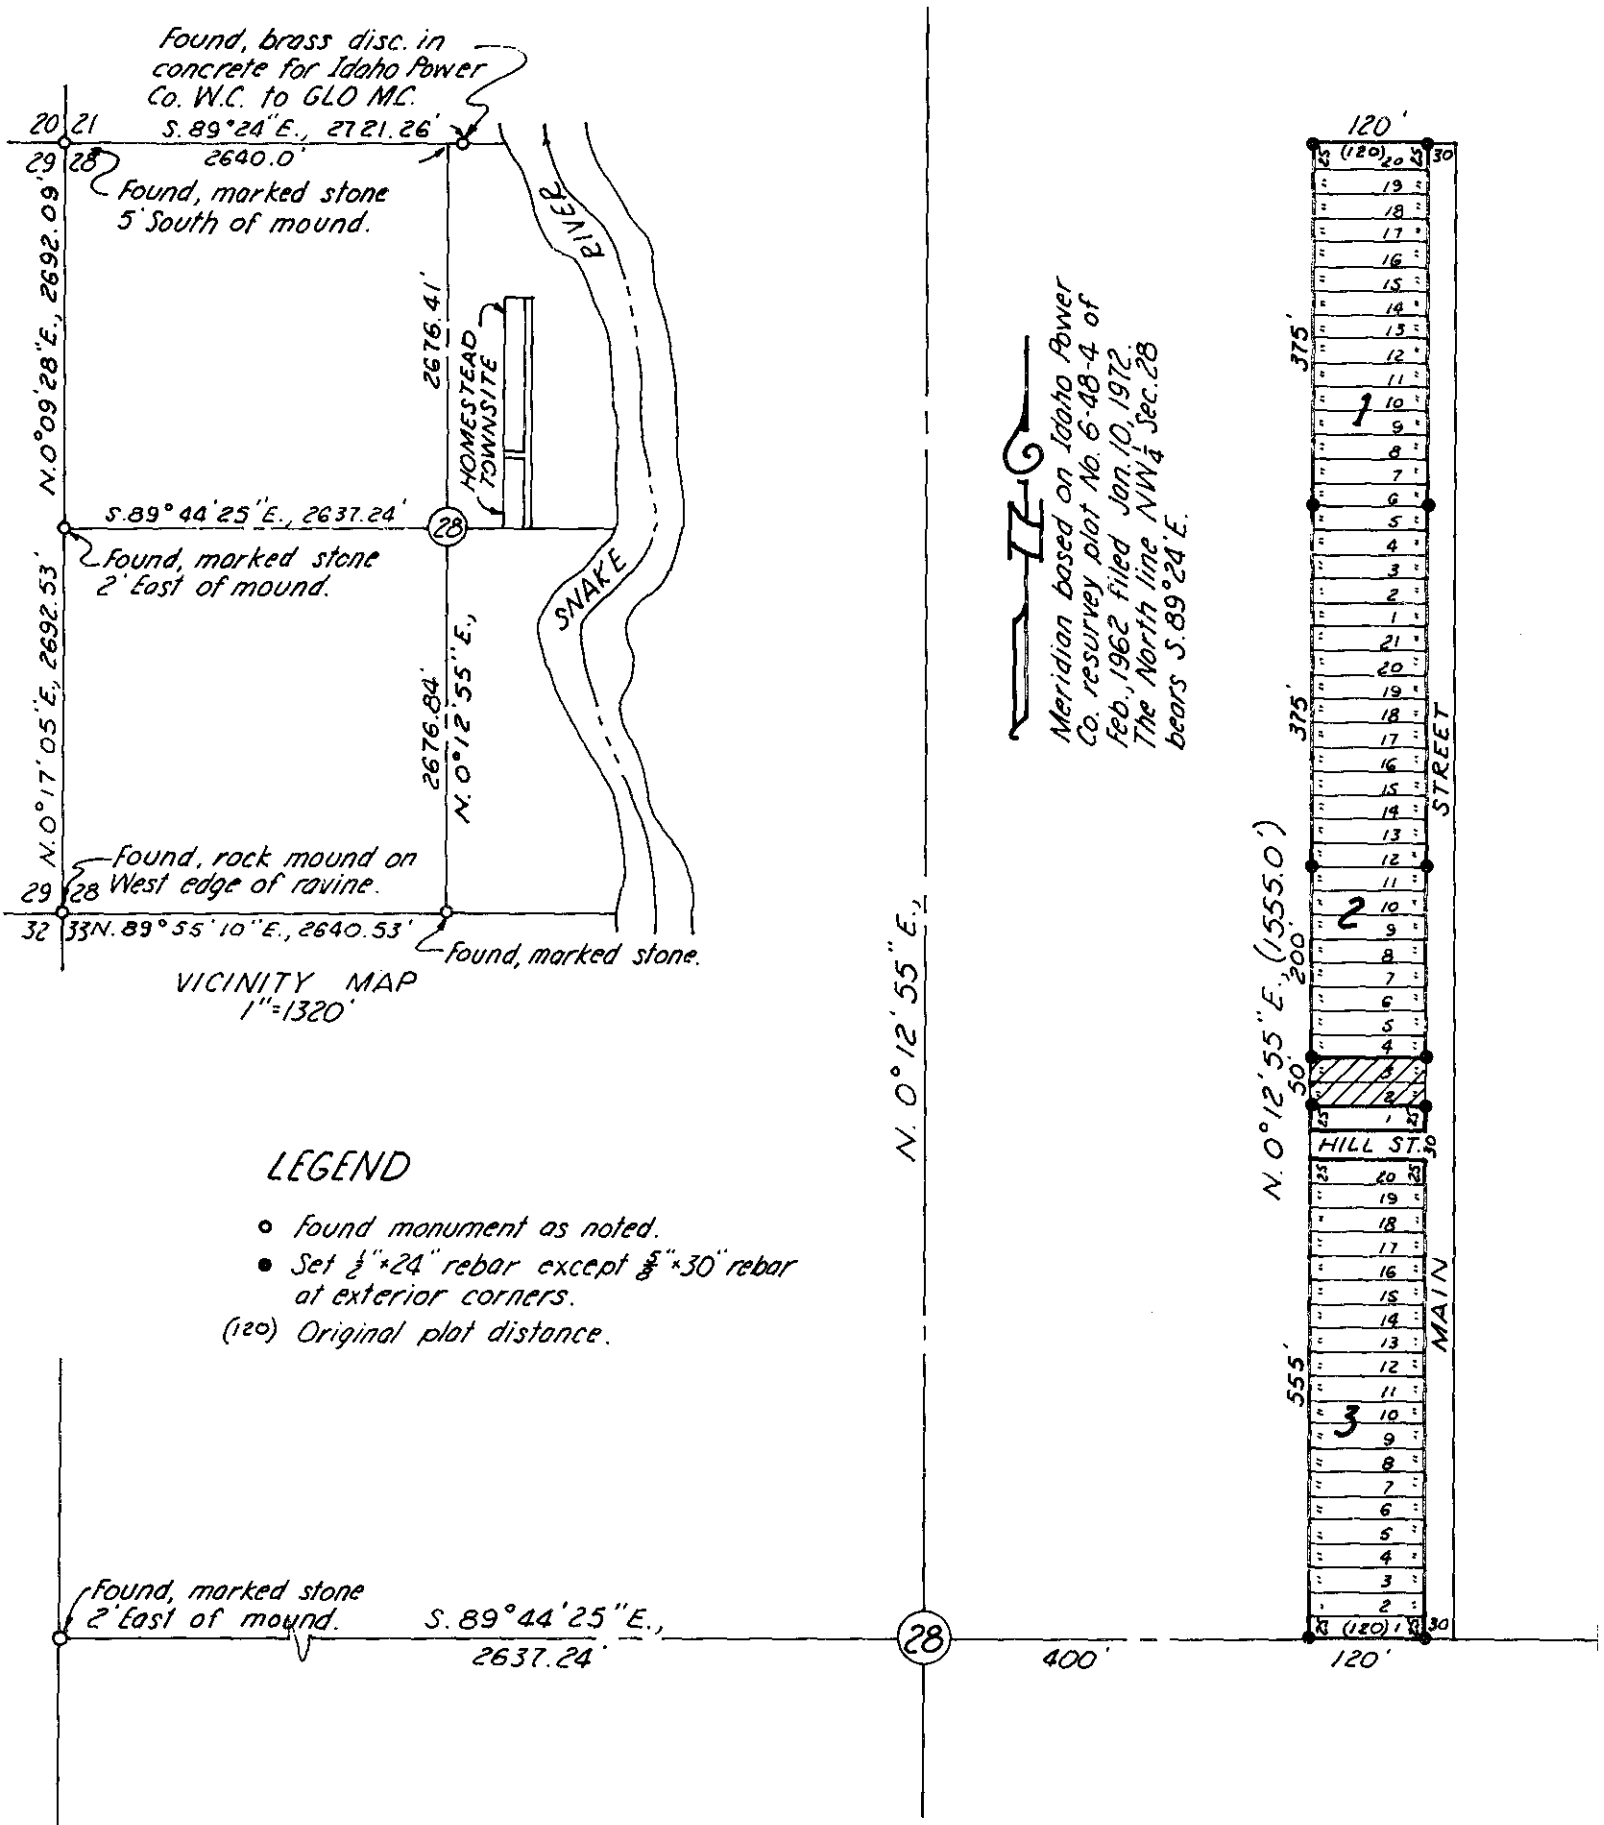

MAP OF SURVEY

THE HOMESTEAD TOWNSITE

IN SECTION 28, T.6S., R.48E., W.M.

Surveyed March 15 & 23, 1978 Scale 1"=200'

For Everett Wilmarth

FILED March 27, 1978
BAKER COUNTY SURVEYOR
SURVEY NO. 6-48-6

REGISTERED PROFESSIONAL LAND SURVEYOR
James D. Hanley
OREGON
SEPTEMBER 23, 1977
JAMES D. HANLEY
1206