


CERTIFIED RECORD OF LAND CORNER MONUMENTATION

Index File No. Z-7

History of original corner establishment:

Corner was originally established under GLO contract number 707, by Willard B. Blakeslee on August 14, 1901. Surveyor General's notes state: "Set a basalt stone 14 x 10 x 6 ins. 8 ins. in the grn., for 1/4 sec. cor. marked 1/4S on the N. face from which a pine tree 21 ins. in diam. brs. S20°W, 50 lks. dist. marked 1/4 S5 BT. No other trees within limits. Raised a mound of stone 3 ft. base 24 ins. high 10 lks. N. of the cor."

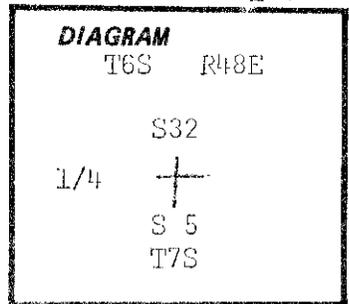


Description of corner evidence found:

Found 14 x 10 x 6 inch stone, faintly marked 1/4 on top. From which a 32" pine bears S20°W., 33.0 ft., with grown-over blazes.

Description of monument and accessories I established to perpetuate the original location of this corner:


At the center of the above point, set 2 1/2" x 30" galvanized pipe and brass cap marked as shown. Set pipe 18" in the ground to bedrock and mound of stone around to cap. Buried marked stone alongside. Old BT is the only tree in the area. Painted healed blaze and 6" red band around old BT. Placed 54-3 and 54-4 on BT. Built mound of stone 3 ft. base and 3 ft. high, 5 ft. north of the corner. Placed 54-4 on a steel fence post 5 ft. west of the corner.

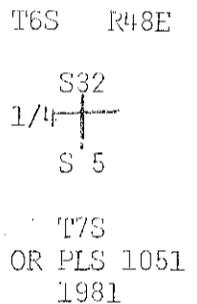

I hereby certify that the above corner monument was reestablished as herein described.

Witnesses: David Cummins
Brian Cays

April 25, 1981

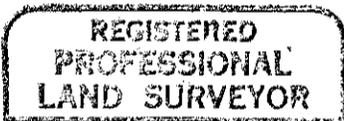

Barry H. Barbour
 OREGON
 OCT. 17, 1975
 BARRY H. BARBOUR
 1031

Office of County Surveyor County of Baker
 State of Oregon, I hereby certify that the within instrument was filed in this office
 for record on the June day of June, 1981
 by [Signature] (DEPUTY)

See Survey 6-48-14
 Filed June 1, 1994,
 for conflicting evidence.
 T. Fisk

FILED July 27, 1981
 BAKER COUNTY SURVEYOR
 SURVEY NO. 6-48-12