




Land Surveying & Boundary Consulting

32610 Mountain Lakes Drive  
Klamath Falls, OR 97601  
(541) 356-2381

**CERTIFIED RECORD OF LAND  
CORNER MONUMENTATION**

45° 04' 41.820" N  
116° 50' 26.810" W  
+/- 5 meters  
NAD 83

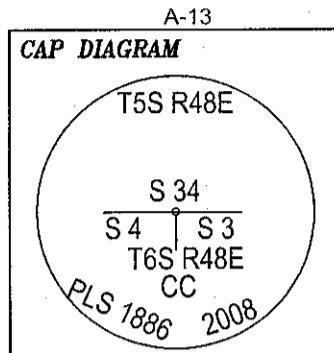

**History of original corner establishment:**

Williard B. Blakeslee, GLO, 1901

**Monument Set:**

A basalt stone, 15 x 10 x 6 ins., 10 ins. in the ground, on the standard parallel. marked CC on the S, with 3 notches on the E and W faces, raised a mound of stone 3 ft. base 24 ins. high 10 lks. (6.6 ft.) S of the corner. Pits impractical.

Standard Corner 33 & 34 bears W 6.6 ft.

**Accessories Set:**

None

**Description of corner evidence found:**

**Monument Found:**

A granite stone 18 x 12 x 8 ins. (Record: basalt 15 x 10 x 6 ins.) no marks found. The stone is very rough.

A mound of stone 24 ins. base x 12 ins. high bears South 6.6 ft.

The standard Corner between sections 33 and 34 bears West 6.6 ft.

**Accessories Found:**

None set, none found.

**Description of monument and accessories established to perpetuate corner:**

**Monument Set:**

Replaced stone with a 2 in. aluminum cap on a 5/8 in. rebar 30 ins. long 18 ins. in the ground to solid rock.

Original stone is placed on the NE side of the new monument.


**Accessories Set:**

A 5/8 x 30 in. rebar driven to solid rock with a 2 in. aluminum cap showing 9 ins. above ground bears S 30° E 8.7 ft.

A 5/8 x 30 in. rebar driven to solid rock with a 2 in. aluminum cap showing 12 ins. above ground bears S 20° W 7.9 ft.

The northeast RM for the standard corner between sections 33 and 34 bears N 38° W 7.7 ft.

The standard corner between sections 33 and 34 bears West 6.6 ft.

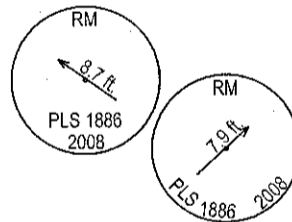

**Equipment:** Warren Knight staff compass with tripod, Var. 15 1/2° E,

Keson tape, clinometer, loggers tape

**Crew:** Richard Chesebro & Ron Grace

**Date:** July 29, 2008

Office of.....County...Surveyor..... County of.....Baker.....  
State of.....Oregon....., I hereby certify that the within was filed  
in this office for record on the..... day of....., 20.....  
..... by .....  
(COUNTY OFFICIAL) (DEPUTY)

119/09  
REGISTERED  
PROFESSIONAL  
LAND SURVEYOR

Richard Chesebro  
OREGON  
JULY 18, 1980  
Richard A. Chesebro  
1886

Renews: 12-31-2009

FILED Jan. 14, 2009  
BAKER COUNTY SURVEYOR  
SURVEY NO. 6-48-17