




Land Surveying & Boundary Consulting

32610 Mountain Lakes Drive
Klamath Falls, OR 97601
(541) 356-2381

**CERTIFIED RECORD OF LAND
CORNER MONUMENTATION**

45° 04' 41.890" N
116° 50' 26.840" W
+/- 5 Meters.
NAD 83

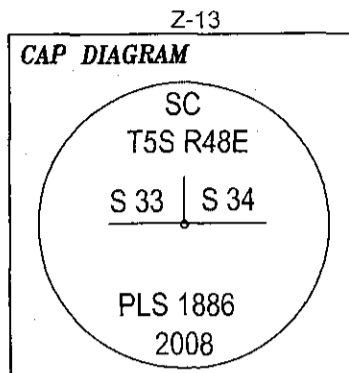

History of original corner establishment:

Williard B. Blakeslee, GLO, 1901

Set: A granite stone, 20 x 8 x 8 ins., 12 ins. in the ground, marked SC on the N, with 3 notches on the E & W faces and raised a mound of stone 3 ft. base, 22 ins. high, 10 lks. (6.6 ft.) N. of the corner. Pits impracticable

Description of corner evidence found:

Monument Found:

A basalt stone 16 x 10 x 3 ins. (Record granite stone 20 x 8 x 8 ins.) laying on its southerly face clearly marked with 3 grooves on the E edges and 2 grooves clearly visible on the W edge (the 3rd groove has broken off). Also there are 6 clearly marked grooves on the S face with an upside down and backward SC visible on the N face.

A mound of stone 3 ft. diam., 1 ft. high bears North 4.0 ft. with 2 old Forest Service boundary signs in the center and a steel fence post with an old BLM Location tag laying beside the mound.

Accessories Found:

None set, none found.

Description of monument and accessories established to perpetuate corner:

Monument Set:

Replaced stone with a 3 1/4 in. aluminum cap on a 2 1/4 in. diam., aluminum pipe 30 ins. long (standard USDA Forest Service monument), buried 12 ins. in the ground to solid rock, with a 2 ft diam. x 1 1/2 ft. high mound.

Original stone is buried on the N side of the new monument.


Accessories Set:

A 5/8 x 30 in. rebar driven to solid rock with a 2 in. aluminum cap showing 17 ins. above ground bears N 18° E 6.1 ft.

A 5/8 x 30 in. rebar driven to solid rock with a 2 in. aluminum cap showing 10 ins. above ground bears N 61° W 7.3 ft.

The southwest RM for the closing corner between sections 3 and 4 bears S 28° E 8.6 ft.

The closing corner between sections 3 and 4 bears East 6.6 ft.

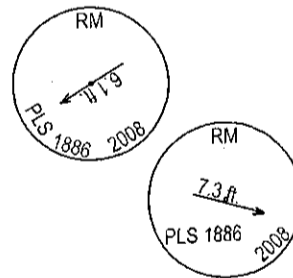

Equipment: Warren Knight staff compass with tripod, Var. 15 1/2° E, Keson tape, clinometer, loggers tape

Crew: Richard Chesebro & Ron Grace

Date: July 29, 2008

FILED JAN 14 2009
BAKER COUNTY SURVEYOR
SURVEY NO. 6-48-18

1/9/09
REGISTERED
PROFESSIONAL
LAND SURVEYOR

Office of.....County.....Surveyor..... County of.....Baker.....
State of.....Oregon....., I hereby certify that the within was filed
in this office for record on the..... day of....., 20.....
..... by
(COUNTY OFFICIAL) (DEPUTY)

Richard Chesebro
OREGON
JULY 18, 1980
Richard A. Chesebro
1886
Renews: 12-31-2009