

# CHESEBRO & KALB

Land Surveying & Boundary Consulting

32610 Mountain Lakes Drive  
Klamath Falls, OR 97601  
(541) 356-2381

## CERTIFIED RECORD OF LAND CORNER MONUMENTATION

### History of original corner establishment:

**Williard B. Blakeslee, GLO, 1901**

**Monument Set:**

A basalt stone, 24 x 4 x 4 ins., 14 ins. in the ground, marked 1/4 S on the W face, from which:

**Accessories Set:**

- A fir, 16 ins. diam., bears N 40° E 50 lks., (33.0 ft.) marked 1/4 S4 BT.
- A fir, 10 ins. diam., bears N 60° W 100 lks. (66.0 ft.) marked 1/4 S5 BT.

### Description of corner evidence found:

**Monument Found:**

A basalt stone 18 x 7 x 7 ins. clearly marked 1/4 S on the W. face setting on top of the ground with a rock mound 18 ins. diam., 12 ins. high immediately E. of the stone.

**Accessories Found:**

A Douglas fir, burnt and dead, 30 ins. diam., bears N 43° E 35.0 ft. (Record: N 40° E 50 lks. (33.0 ft.), no scribing visible because of burnt face. This tree has a large swoop to the SE and has an old 1959 BLM Location Tag. (Original)

A Douglas fir, 24 ins. diam., bears N 73° W 80.7 ft., with healed double blaze. Tree has a 1959 BLM Location Tag marked S 70° E 126 lks. (83.2 ft.). Tree has a broken top and has not been burnt. (Origin unknown)

No evidence was found of the original NW bearing tree.

### Description of monument and accessories established to perpetuate corner:

**Monument Set:**

Replaced stone with a 3 1/4 in. aluminum cap on a 2 1/4 in. diam., aluminum pipe 30 ins. long (standard USDA Forest Service monument), buried 8 ins. in the ground to solid rock, with a 2 ft. diam. x 2 ft. high mound.

Original stone is buried on the N side of the new monument.

**Accessories Set:**

A 5/8 x 30 in. rebar driven to solid rock with a 2 in. aluminum cap showing 18 ins. above ground bears N 41° E 11.6 ft. with 2 ft. diam. mound of stones to top.

A 5/8 x 30 in. rebar driven to solid rock with a 2 in. aluminum cap showing 14 ins. above ground bears S 54° E 9.9 ft. with 17 ins. x 8 in. high mound of stones.

A 5/8 x 30 in. rebar driven to solid rock with a 2 in. aluminum cap showing 18 ins. above ground bears S 55° W 11.4 ft. with 20 ins. x 8 in. high mound of stones.



A 5/8 x 30 in. rebar driven to solid rock with a 2 in. aluminum cap showing 18 ins. above ground bears N 53° W 9.4 ft. with 1.5 ft. high mound of stones.

**Equipment:** Warren Knight staff compass with tripod, Var. 15 1/2° E, Keson tape, clinometer, loggers tape

**Crew:** Richard Chesebro & Ron Grace

**Date:** July 30, 2008

45° 04' 16.580" N  
116° 51' 39.240" W  
+/- 5 Meters.  
NAD 83

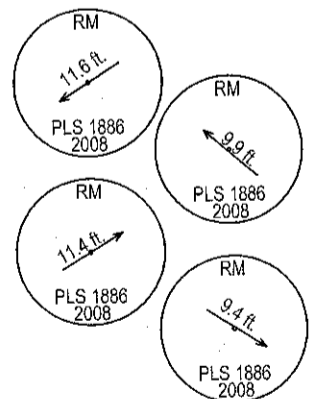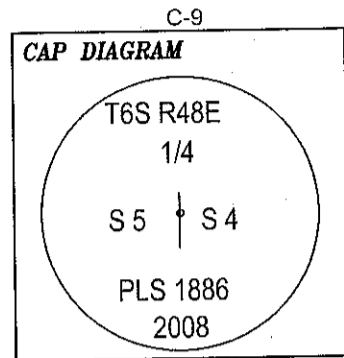

Office of.....County Surveyor..... County of.....Baker.....  
State of.....Oregon....., I hereby certify that the within was filed  
in this office for record on the..... day of....., 20.....  
..... by .....  
(COUNTY OFFICIAL) (DEPUTY)

1/9/09  
REGISTERED PROFESSIONAL LAND SURVEYOR

Richard Chesebro  
OREGON  
JULY 18, 1980  
Richard A. Chesebro  
1886  
Renews: 12-31-2009

FILED JAN. 14, 2009  
BAKER COUNTY SURVEYOR  
SURVEY NO. 6-48-19