

CERTIFIED RECORD OF LAND CORNER MONUMENTATION

History of original corner establishment:

Original corner set by Eugene P. McCormack, under GLO Contract No. 398, approved March 25, 1881.
Record states: Set basalt stone 24x14x9 ins. 18 ins. in the ground for 1/4 sec cor. marked 1/4S on W face. From which:
A pine, 12 ins. diam., bears N 55° E, 29 lks. dist., marked: 1/4S BT.
A pine, 4 ins. diam., bears N 40° W, 20 lks. dist., marked: 1/4S BT.

Subsequent Monumentation

Corner was remonumented by Lester E. Fischer and James J. Carlson, under BLM Group No. 350, approved June 13, 1977.
Record states: The 1/4 sec. cor. of sec. 7 only, on the W. bdy. of the Tp., determined at record distance from the remains of the original bearing trees:
A ponderosa pine, 22 ins. diam., bears N. 64¼° E., 29 lks. dist., with healed double blaze. (Record, N. 55°E.)
A ponderosa pine snag, 13 ins. diam., bears N. 40° W., 20 lks. dist., with scribe marks 1/4 S BT visible on open blaze.
At the corner point: Set an iron post, 28 ins. long 2½ ins. diam., 24 ins. in the ground, with brass cap mkd (as shown below), from which a new bearing tree:
A ponderosa pine, 11 ins. diam., bears S. 68° E., 26½ lks. dist., mkd 1/4 S7 BT.

Corner was perpetuated by J. David Brinton, LS 2065, as described by Survey No. 7-38-43, filed February 15, 1985, in the records of the Baker County Surveyor.
Record states: Found 3" brass cap monument, on 2½" iron pipe. stamped (as shown below), set with 4" above the ground. Found original bearing trees as follows:
A ponderosa pine, 22 ins. diam., bears N64-1/2E., 29lks., dist., with healed double blaze. (Record N55E), is live in good condition.
A ponderosa pine, snag, 13 ins. diam., bears N40W., 20 lks. dist., with scribe marks 1/4 S BT.
Found the bearing tree taken in 1975, A ponderosa pine, 11 ins. diam., dead and standing bears N55E., 27.12 lks. (Record S68E 26.5 lks.), scribing reads 1/4 S7 BT.
Re scribed original bearing tree, a ponderosa pine 24" dia. bears. N 64-1/2E, 19.1 ft., scribed 1/4 S7 BT. nailed brass washer stamped PLS 2065 to blaze above BT scribe.
Scribed a new bearing tree, a fir 6" dia. bears East 18.8 ft. scribed 1/4 S7 BT, painted a 6" red band around tree, nailed a brass washer above BT Scribe and nailed bearing tree and warning sign to back of tree taken in 1975..

Description of corner evidence found:

Found 2½ ins. diam. iron pipe, flush with ground, with rock collar, and ¾ ins. diam. standard BLM brass cap, marked as shown:
From the recovered monument I find the original bearing trees:
A ponderosa pine, 27 ins. diam., bears N. 55° E., 18.3 ft. dist., alive and healthy, with healed double blaze. (BLM record: N. 64¼° E., 29 lks. bearing matches GLO record, hold new distance)
A rotting pine snag, bears N. 40° W., 16.3 ft. dist., with 1/4 S BT visible on open double blaze. (Record 20 lks)
And accessories mkd. by Fischer:
A rotting cut pine stump, bears S. 58° E., 20.5 ft. dist., no scribe marks legible on blaze. (BLM Record: S. 68° E. 26½ lks; Brinton Record: N. 55° E., 27.12 lks.)
And accessories mkd. by Brinton:
A white fir, 13 ins. diam., bears N. 88° E., 18.8 ft. dist., alive and healthy, with healed blaze. (Record: East)

Found guard posts ±1.5 ft. S'ly with Property Boundary (54-2) and Attention (54-4) signs, and ±3 ft. N'ly with Attention (54-4) and Property Boundary (54-2) signs attached.

Description of monument and accessories I established to perpetuate original location of this corner:

New bearing trees:
A tamarack, 9 ins. diam., bears N. 22° E, 26.1 ft. dist., mkd. 1/4 S7 BT.
A tamarack, 12 ins. diam., bears S. 38½° E, 50.2 ft. dist., mkd. 1/4 S7 BT.

All new bearing trees are marked on a single blaze and have a nail with a brass washer stamped "LS 2648" right side center for distance measurements.



Corner falls in 10 ft. wide logging road bearing N-S.

Painted 6 ins. red bands and added Bearing Tree (54-3) and Land Survey Monument (54-9) signs as needed to all bearing trees. Did not alter existing bearing tree tags to reflect record changes.

Auto C/A geographic position:
Lat. 44°58'12.1" N
Long. 118°06'57.1" W

I hereby certify that the corner is monumented and accessories taken as described, using a Warren Knight staff compass, set with 15° East declination, and steel tape on September 5, 2014.

Witnesses: Brenda Johnson

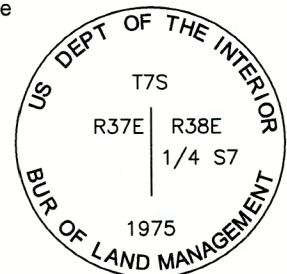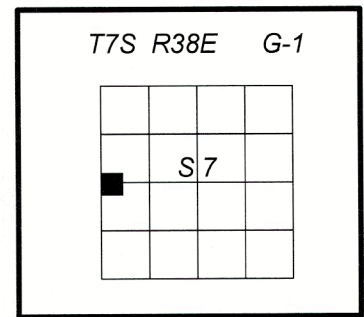

REGISTERED
PROFESSIONAL
LAND SURVEYOR

Deceased

OREGON
JANUARY 18, 1994
RON C. WALTER
2648

Renewal Date: June 30, 2016

REGISTERED
PROFESSIONAL
LAND SURVEYOR

With R. Wells

OREGON
July 22, 1977
WILLIAM R. WELLS
1106

Renewal Date: June 30, 2016

FILED Feb. 25, 2015
BAKER COUNTY SURVEYOR

SURVEY NO. 7-37-5
7-38-114

NOTE: See "Explanation for Successor Certifying Surveyor" statement in Narrative of Record of Survey, CS 7-38-107, filed concurrently with this Land Corner Record.