


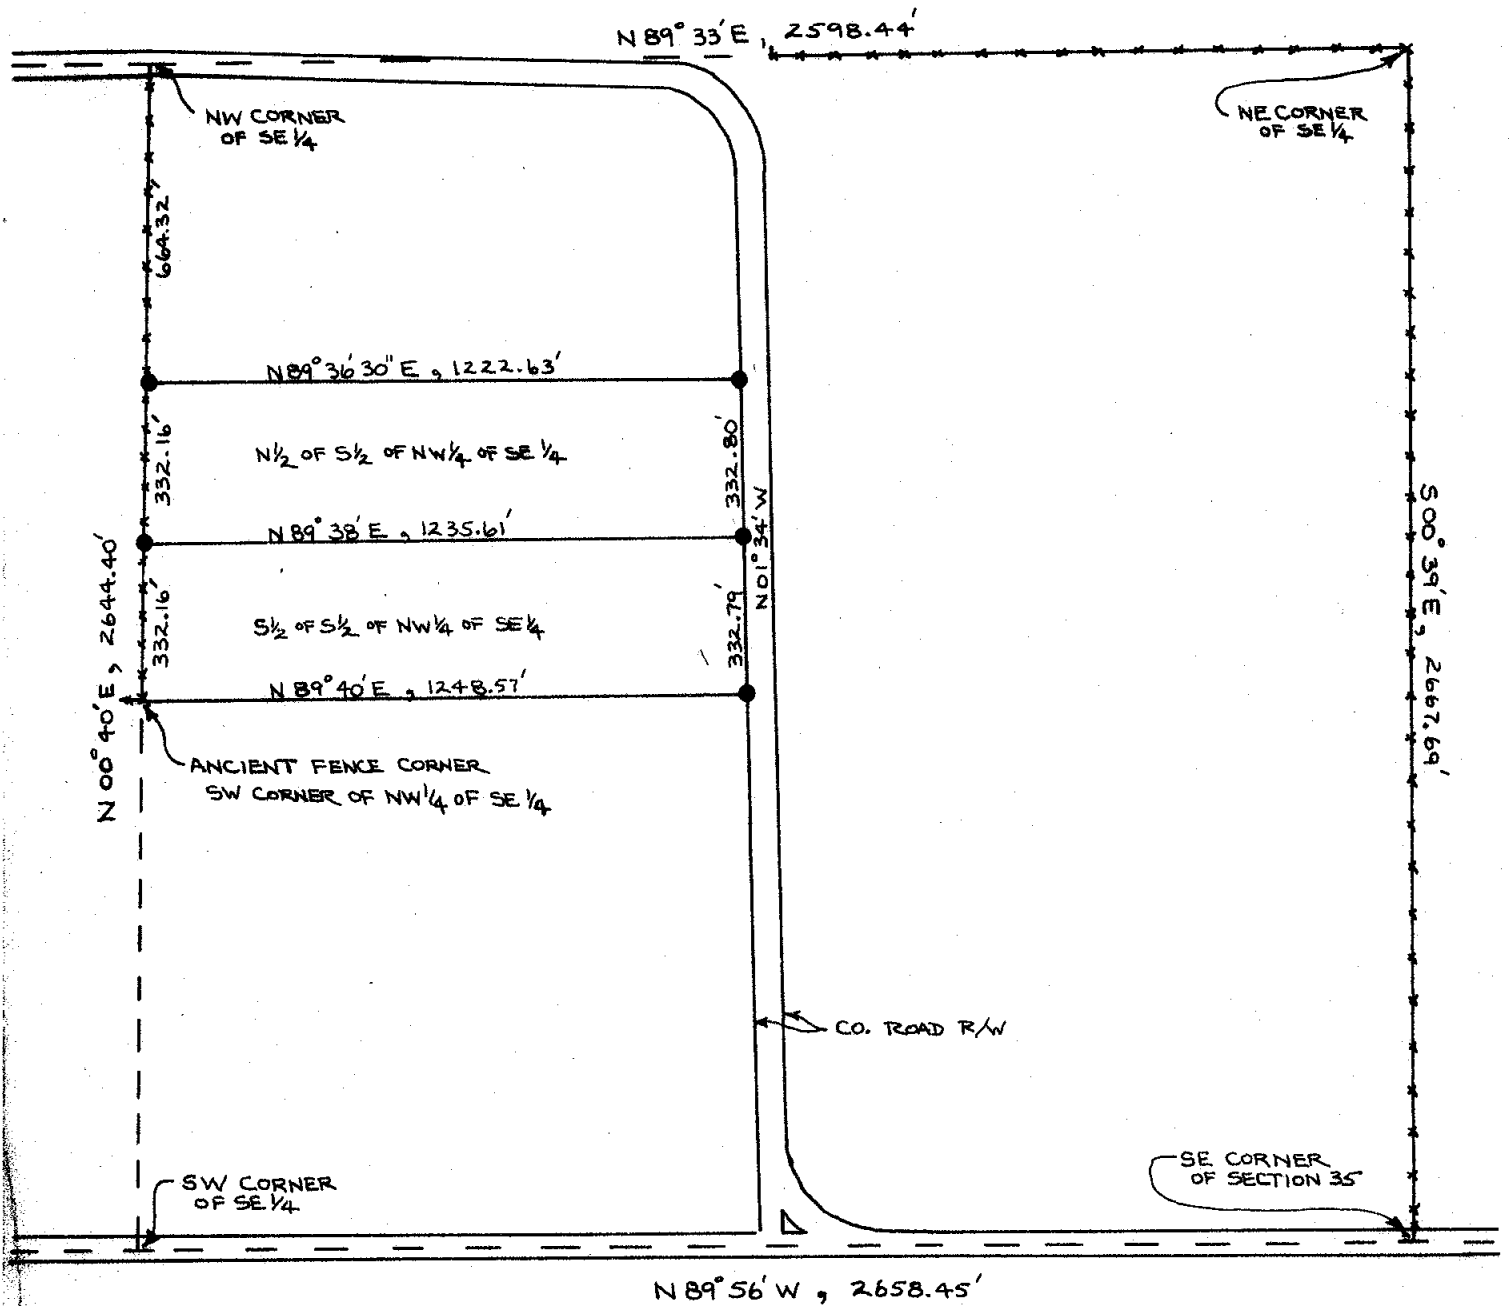

RECORD OF SURVEY FOR

LOUISE LAGIER

OF A PORTION OF THE S 1/2 OF NW 1/4 OF SE 1/4
SECTION 35, T.7S., R.38 E., W.M.
BAKER COUNTY, OREGON

LEGEND

- *** FENCE
- SET 5/8" IRON ROD



BASIS OF BEARING -
SOLAR OBSERVATION

SCALE: 1" = 400'

OCTOBER 20, 1971



SURVEYED BY- TELEK ENGINEERING, BAKER

FILED 1-19-72

BAKER COUNTY SURVEYOR

SURVEY NO. 7-38-1